	LAND CORNE	R RECORDATION CER	ITIFICATE		1	
For corners in	Filing Require	ement of Act 74, Mich.	P.A. 1970	E×	SFP 3	
Livingston	Located in:	Corner Code ##		HANCY EGISTE INGSTO	_ 	!
1. Public Land Survey	T R	L-9		HAVILAND R OF DEEDS N COUNTY, H1	3 28 PM '94	, •
2. Property Controlling	S T R S T R		L.S.C.# 235m			
in Section 3. Miscellaneous Property in Sec.	S T R S T R		Register of De	eds Stamp &	File Number	
4. Lot No Re- 5. Private Claims E, Charles E Garlock, do hereby certify that under requirent manual of survey instruct Management or by a decree of a Company were in conformance with Dourt of Law; established, re- Expressed below:	in a field survey on ALIC irements of P.A. 74, Michigan P.A. conformance with regulations an tions of the United States Depart court of Law and/or that the corne the rules of the Michigan Board of	of 1970, the corner points mend fules therefore as required the Interior, Bureau or points mentioned in lines 3, of Land Surveyors or by a Dec	2 6 3 4 7 1 1 1 1 1 1 1 1 1 1 1 1 1 1 1 1 1 1	D E F G	H 1 J K 1 -3 - 2	13-2425
Not more than 4 cor on this certificate.	ners, all in the same town ar	nd range, may be recorde	11 12 31 13 13 13 14 15 15 15 15 15 15 15 15 15 15 15 15 15	-32 - 33 -	-3435	36-
4. Description of original mo	onument and accessories and April 15, 1825 by S.S.	d/or subsequent restoration				-

See additional data on rear of sheet Description of corner evidence found and/or method applied in restoring or reestablishing corner: Found 1/2" I. Rod set in 1964 from data found in HIGHLAND BEACH SUB.

W09-N75E-0.40 ch

BO 14-N48 1/2W-0.28 ch

SURVEY & REMONUMENTATION

SEP 2 6 1994

COMMISSION

Description of monument for corner and accessories established to perpetuate locating the position of the corner: L-9: South 1/4 cor. Sec. 24, T2N-R4E, Marion Twp. Liv.Co.MI., set 1 1/4" X 36" I. Pipe with breakaway top and Liv. Co. Remon brass cap on top at -0.5' West-4-5'±-to Ctr. of South Woods Rd. S85E-92.00'-SW cor. brick veneer garage Hse #4001 S40E-20.19'-sp W/s 53" W Oak (sp & tag) N45E-36.90'-sp & tag W/s 19" Hickory CHARLES F West-52.49'-sp & tag N/s 28" W Cherry GARLOCK PROFESSIONAL SURVEYOR \$45W-54.5'-ctr. 6" Spruce No. 14762 OFESSIONS

■veyor's Michigan License No.

GLO witnessess:

14762

August 19,

REVISED MAY 14, 1975


REVISED JAN., 1983

L-9 N 1/4 Cor. Sec.25, Marion Twp., Livingston Co., MJ

GLO dated April 15, 1825 by S. Sibley, D.S. GLO notes call for the 1/4 corner to be set at 1/2 distance between the NW and NE corners of the Section, which is 2616. 57 feet. In 1920 GH Dunning measured from the NW to the NE corners of the section a distance of 5132 feet, triangulating across Coon Lake. PL Benton and myself measured 5124.29 feet and 5124.37 feet. It appears GH Dunning then set the N 1/4 corner at 2616 feet West of the NE corner of said Section and the 1/8 corner at 1/2 distance of 1308 feet. Dunning also stated that he found a fence line to the South at 1238 feet West of the N 1/4 corner and that it was 1278 from this fence West to the NW corner of the Section; Boss Engr., PL Benton and myself have measured 1275 to this fence from the NW corner. In 1923 and 24, CW Gordon surveyed and platted HIGHLAND BEACH SUB., L2 pg.44 LCR, he located the N 1/4 corner and witnessed it in his field notes but did not show it on the plat (???), this was 3 years after Dunning's survey. In 1964 I did not find the N 1/4 corner and reset it based on Gordon's field notes and the plat of HIGHLAND BEACH SUB., this set 1/2" I. Rod, that I found now, matches a Dunning witness of 19.0' to the face of an Oak that I measure 21.05' to the centerline of a 40" Oak.

Found no other irons in the area.

Area is fairly clear to the West, but several trees to the East.

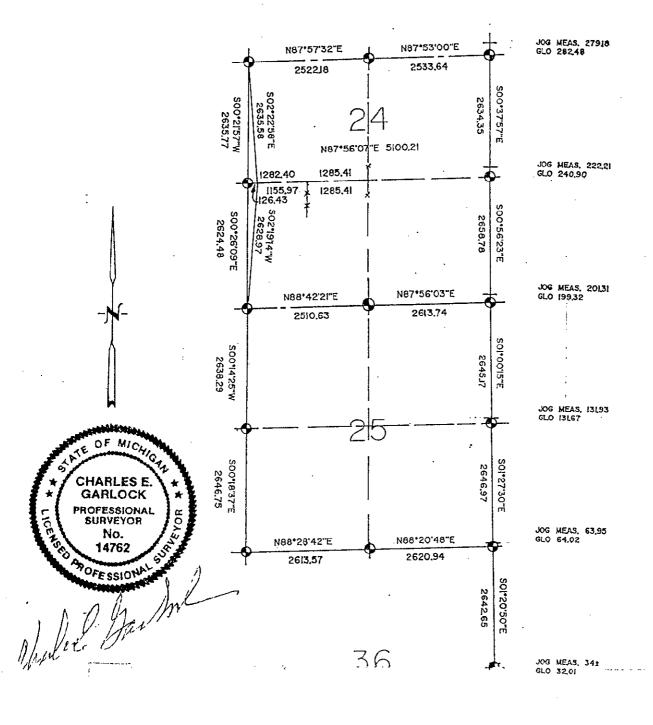

57 34-42

17