

FILED

9

LAND CORNER RECORDATION CERTIFICATE

Filing Requirement of Act 74, Mich. P.A. 1970

MAY 9 11 03 AM '95

NANCY HAVILAND
REGISTER OF DEEDS
LIVINGSTON COUNTY, MI
48843

C.L.S.#396m

Register of Deeds Stamp & File Number

For corners in

Livingston

(County)

Located In:

Corner Code ##

1. Public Land Survey

T 2N R 4E

M-3

T R

T R

T R

T R

2. Property Controlling

S T R

S T R

S T R

S T R

3. Miscellaneous

S T R

S T R

Property in Sec.

4. Lot No. , Recorded Plat

5. Private Claims

Charles E Garlock, in a field survey on April 28, 1995

I hereby certify that under requirements of P.A. 74, Michigan P.A. of 1970, the corner points mentioned in lines 1 and 2 above were in conformance with regulations and rules therefore as required in the current manual of survey instructions of the United States Department of the Interior, Bureau of Land Management or by a decree of a Court of Law and/or that the corner points mentioned in lines 3, 4 and 5 above were in conformance with the rules of the Michigan Board of Land Surveyors or by a Decree of a Court of Law; established, re-established, monumented, re-monumented, recovered, found as expressed below:

NOTE: Not more than 4 corners, all in the same town and range, may be recorded on this certificate.

Description of original monument and accessories and/or subsequent restoration:

GLO survey dated: April 15, 1825 by S Sibley, DS

GLO witnessess: W017-S56 1/2 W-196 lks

W07-N3W-230 lks

Additional historical survey data on rear of sheet.

Description of corner evidence found and/or method applied in restoring or reestablishing corner:

Found 1" I. Pipe 24" long in c/l of Fisk Road.


SURVEY &
RECONSTITUTION

OCT 3 1995

COMMISSION

Description of monument for corner and accessories established to perpetuate locating the position of the corner:

M-3: Northeast corner Section 12, T2N-R4E, Marion Twp. Liv. Co. MI, reset 1" I. Pipe with 1 1/4" X 36" breakaway I. Pipe with Liv. Co. Remon brass cap on top at -0.5' South-2.60'-North edge of Conc. bridge
S85E-13.60'-NW cor. conc. bridge railing post
S85W-13.70'-NE cor. Conc. bridge railing post
N40E-42.73'-sp & tag N/s U. Pole
N10E-174.68'-sp & tag W/s U. Pole
North-392.70'-NW cor. Sec. 7 T2N-R5E
On c/l of bridge deck and Fisk Rd.

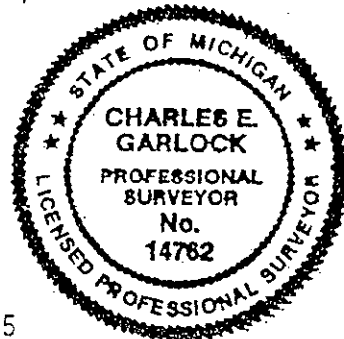

igned by

Charles E. Garlock

Date April 29, 1995

Surveyor's Michigan License No. 14762

P.A. 345 1990, APPROVED BY LIVINGSTON COUNTY

3-1-95 JED

FORM APPROVED BY MICHIGAN STATE BOARD OF LAND SURVEYORS, JAN. 28, 1971
REVISED MAY 14, 1975
REVISED JAN., 1983

CORNER SUMMARY

M-3: NE COR. SEC. 12, T2N-R4E, MARION TWP. LIV. CO. MI

GLO SURVEY DATED APRIL 15, 1825 BY S SIBLEY AND NONE OF THE GLO WITNESSES REMAIN.

M BULLOCK IN 1893 WITNESSED THE CORNER BUT NONE REMAIN TODAY. NEXT KNOWN ACTIVITY WAS C GORDON IN 1948 WHEN HE HAD A MEASURE OF 392.7 FT. NORTH TO THE SEC. COR. IN GENOA TWP. WHICH WAS ALSO THE GLO DISTANCE (BOTH POINTS ARE NOW SEPARATED BY I-96 TODAY, WITH THE GENOA CORNER NEAR OR IN THE W.B. LANE OF I-96). MEASURES BY L MUNSELL AND MDOT TO THE GENOA CORNER REMAINS AT 392.70 FT. SURVEYORS FROM 1959 TO PRESENT HAVE FOUND A 3/4" I. PIPE ABOUT 2.15 FT. NORTH OF THE NORTH EDGE OF A CONCRETE BRIDGE. WITNESSES BY BENTON, BOSS MDOT, MUNSELL AND MYSELF CHECK WITH THE NOW FOUND 3/4" I. PIPE. THE IRON LINES WITH THE N.-S. GRAVEL ROAD AND LINES WITH FRANCIS ROAD TO THE WEST TO THE N 1/4 CORNER AFTER IT RETURNS TO THE SECTION LINE. MEASURES WEST TO THE N 1/4 CORNER: 2602.26 FT. = BOSS AND MYSELF; SOUTH TO THE E 1/4 CORNER: 2705.43 FT. BY MYSELF (A WILD ONE AT 2708.33) AND 2705.56 BY BOSS. ONE ACT 74 IS RECORDED AND FIVE ACT 132'S RECORDED. OVERHANGING TREES MAKE THIS A POOR GPS STATION.



CHARLES GARLOCK
PS14762
M3MAR95

