

SURVEY &
REMONUMENTATION

FEB 26 2001

FILED

SECTION

LAND CORNER RECORDATION CERTIFICATE
Filing Requirement of Act 74, Mich. P.A. 1970

For corners in

LIVINGSTON Located In: Corner Code #
(County)

1. Public Land Survey T 2 N R 4 E E-11
T R
T R
T R

2. Property Controlling S T R
in Section S T R

3. Miscellaneous S T R
Property in Sec. S T R

2000 NOV -8 A 9:43

NANCY HAVILAND
REGISTER OF DEEDS
LIVINGSTON COUNTY, MI.
48843

LSC #1349m

Register of Deeds Stamp & File Number

4. Lot No. _____, Recorded Plat _____
5. Private Claims _____

I, JACK K. SMITH, in a field survey on OCT. 4, 2000, do hereby state that under requirements of P.A. 74, Michigan P.A. of 1970, the corner points mentioned in lines 1 and 2 above were in conformance with regulations and rules therefore as required in the current manual of survey instructions of the United States Department of the Interior, Bureau of Land Management or by a decree of a Court of Law and /or that the corner points mentioned in lines 3, 4 and 5 above were in conformance with the rules of the Michigan Board of Land Surveyors or by a Decree of a Court of Law; established, re-established, monumented, recovered, found as expressed below:

NOTE: Not more than 2 corners, all in the same town and range, may be recorded on this certificate.

| A | B | C | D | E | F | G | H | I | J | K | L |
|----|----|---|----|---|----|---|----|---|----|---|----|
| 1 | | | | | | | | | | | |
| 2 | 6 | | 5 | | 4 | | 3 | | 2 | | 1 |
| 3 | | | | | | | | | | | |
| 4 | 7 | | 8 | | 9 | | 10 | | 11 | | 12 |
| 5 | | | | | | | | | | | |
| 6 | 18 | | 17 | | 16 | | 15 | | 14 | | 13 |
| 7 | | | | | | | | | | | |
| 8 | 19 | | 20 | | 21 | | 22 | | 23 | | 24 |
| 9 | | | | | | | | | | | |
| 10 | 30 | | 29 | | 28 | | 27 | | 26 | | 25 |
| 11 | | | | | | | | | | | |
| 12 | 31 | | 32 | | 33 | | 34 | | 35 | | 36 |
| 13 | | | | | | | | | | | |

A. Description of original monument and accessories and/or subsequent restoration:

GLO 1825 SIBLEY SET POST
WHITE OAK 21" N35°E 17.16'
WHITE OAK 18" S50°W 8.58'

B. Description of corner evidence found and/or method applied in restoring or reestablishing corner:

WE FOUND MULTIPLE CORNER LOCATIONS MONUMENTED AT E-11. A 5/8"x 12" STEEL ROD THAT APPEARS TO MARK A LOCATION PERPETUATED SINCE AT LEAST 1975 (AND PROBABLY 1958) THAT IS 31 FEET EASTERLY OF THE CENTER LINE OF CEDAR LAKE ROAD AND A 1/2" REROD I SET TO REPLACE A 3/4"x 7" BADLY BENT AND TIPPED PIPE FIRST REPORTED BY BENTON IN 1979 NEAR THE CENTER LINE OF SAID ROAD. THE POSITION MARKED BY THE 5/8" STEEL ROD THAT IS 31 FEET EASTERLY OF THE CENTER LINE OF TRIANGLE LAKE ROAD WAS ACCEPTED.

C. Description of monument for corner and accessories established to perpetuate locating the position of the corner:


E-11 SOUTHWEST CORNER SECTION 28, T2N, R4E, MARION TOWNSHIP, LIVINGSTON COUNTY, MICHIGAN:
REPLACED 5/8" STEEL ROD WITH 1 1/4" X 36" STEEL PIPE WITH BEAK-OFF SECTION AND LIVINGSTON COUNTY REMONUMENTATION BRASS CAP WITH SURVEYOR #35999 31 FEET EASTERLY OF THE CENTER LINE OF CEDAR LAKE ROAD AND 2 FEET NORTHERLY OF A FENCE LINE AND TREE ROW TO THE EAST.

N80°W SPIKE AND LIVINGSTON COUNTY REMON TAG IN THE NE SIDE OF A 26" OAK 88.72'
NORTH SPIKE AND LIVINGSTON COUNTY REMON TAG IN THE EAST SIDE OF A 18" OAK 69.76'
N15°E SPIKE AND LIVINGSTON COUNTY REMON TAG IN THE NE SIDE OF A 12" OAK 16.82'
N80°E SPIKE AND LIVINGSTON COUNTY REMON TAG IN THE NE SIDE OF A 16" OAK 37.87'

Signed by

Date 10-26-2000

Surveyor's Michigan License No. 35999

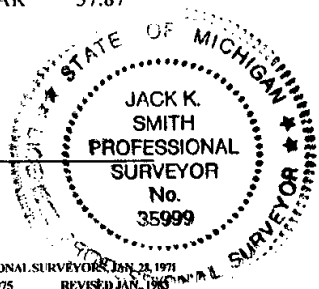

FORM APPROVED BY MICHIGAN STATE BOARD OF PROFESSIONAL SURVEYORS JAN 28, 1971
REVISED MAY 14, 1975 REVISED JAN, 1985

REVISED OCT., 1985

PA. 345 1990, APPROVED BY LIVINGSTON COUNTY
PEER GROUP ON 9-6-2000 CO. REP JED