

SURVEY &
REMONUMENTATION

FEB 26 2001

SECTION

LAND CORNER RECORDATION CERTIFICATE
Filing Requirement of Act 74, Mich. P.A. 1970

FILED

For corners in

LIVINGSTON Located In: Corner Code #
(County)

1. Public Land Survey T 2 N R 4 E F-09
T R
T R
T R

2. Property Controlling S T R
in Section S T R

3. Miscellaneous S T R
Property in Sec. S T R

2000 NOV -8 A 9:43

NANCY HAVILAND
REGISTER OF DEEDS
LIVINGSTON COUNTY, MI.
48843

LSC #1352m

9- Register of Deeds Stamp & File Number

4. Lot No. _____, Recorded Plat _____
5. Private Claims _____

I, JACK K SMITH, in a field survey on AUGUST 4, 2000 do hereby state that under requirements of P.A. 74, Michigan P.A. of 1970, the corner points mentioned in lines 1 and 2 above were in conformance with regulations and rules therefore as required in the current manual of survey instructions of the United States Department of the Interior, Bureau of Land Management or by a decree of a Court of Law and/or that the corner points mentioned in lines 3, 4 and 5 above were in conformance with the rules of the Michigan Board of Land Surveyors or by a Decree of a Court of Law; established, re-established, monumented, recovered, found as expressed below:

NOTE: Not more than 2 corners, all in the same town and range, may be recorded on this certificate.

A	B	C	D	E	F	G	H	I	J	K	L	M
1												
2	6		5		4		3		2		1	
3												
4	7		8		9		10		11		12	
5												
6	18		17		16		15		14		13	
7												
8	19		20		21		22		23		24	
9												
10	30		29		28		27		26		25	
11												
12	31		32		33		34		35		36	
13												

A. Description of original monument and accessories and/or subsequent restoration:

GLO 1825 SIBLEY SET POST
WHITE OAK 14" N 52° E 21.78'
WHITE OAK 10" S 31° W 70.62'

B. Description of corner evidence found and/or method applied in restoring or reestablishing corner:

F-09 IS CURRENTLY MARKED BY A 1/2" REROD NORTHERLY OF THE CENTERLINE OF MAYBERRY DRIVE (A PRIVATE GRAVEL ROAD TO THE EAST) WITH A FENCE AND TREE ROW TO THE SOUTH AND LIGHT OCCUPATION TO THE NORTH. THE CORNER LIES NEAR THE WESTERLY EDGE OF A GRAVEL CUL-DE-SAC.

C. Description of monument for corner and accessories established to perpetuate locating the position of the corner:


F-09 SOUTH 1/4 CORNER SECTION 21, T2N, R4E, MARION TOWNSHIP, LIVINGSTON COUNTY, MICHIGAN:
REPLACED 1/2" REROD WITH 1 1/4" X 36" STEEL PIPE WITH BREAK-OFF SECTION AND LIVINGSTON COUNTY REMONUMENTATION BRASS CAP WITH SURVEYOR #35999 @ 1/2 FOOT ABOVE THE SURFACE OF SURROUNDING GROUND.

S75°W SPIKE AND LIVINGSTON COUNTY REMON TAG IN SOUTH SIDE OF A 30" OAK 3.90'
SOUTH SPIKE AND LIVINGSTON COUNTY REMON TAG IN NW SIDE OF A 16" OAK 32.43'
S40°E SPIKE AND LIVINGSTON COUNTY REMON TAG IN NE SIDE OF A 24" OAK 39.63'
S50°W SPIKE AND LIVINGSTON COUNTY REMON TAG IN SE SIDE OF A 10" WALNUT 51.90'

Signed by

Date

Surveyor's Michigan License No. 35999

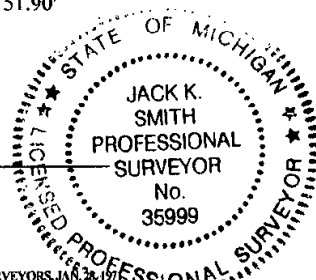

FORM APPROVED BY MICHIGAN STATE BOARD OF PROFESSIONAL SURVEYORS, JAN. 28, 1975
REVISED MAY 14, 1975 REVISED JAN., 1983

REVISED OCT., 1995

P.A. 345 1990, APPROVED BY LIVINGSTON COUNTY
PEER GROUP ON 7-19-2000 CO. REP JED