

FEB 25 1999

SECTION

LAND CORNER RECORDATION CERTIFICATE
Filing Requirement of Act 74, Mich. P.A. 1970

FILED

For corners in

Livingston
(County)

Located In:

Corner Code //

1. Public Land Survey

T 2N R 5E

F-11

2. Property Controlling
in Section

S T R
S T R

3. Miscellaneous
Property in Sec.

S T R
S T R

1998 OCT 22 P 1:18

NANCY HAVILAND
REGISTER OF DEEDS
LIVINGSTON COUNTY, MI.
48843

LSC957M

Register of Deeds Stamp & File Number

1. Lot No. , Recorded Plat

2. Private Claims

Bryan L. Boss, in a field survey on Oct. 8, 19 98,
to hereby certify that under requirements of P.A. 74, Michigan P.A. of 1970, the corner points mentioned
in lines 1 and 2 above were in conformance with regulations and rules therefore as required in the
current manual of survey instructions of the United States Department of the Interior, Bureau of Land
Management or by a decree of a Court of Law and/or that the corner points mentioned in lines 3, 4 and 5
above were in conformance with the rules of the Michigan Board of Land Surveyors or by a Decree of a
Court of Law; established, re-established, monumented, re-monumented, recovered, found as
expressed below:

NOTE: Not more than 4 corners, all in the same town and range, may be recorded
on this certificate.

1. Description of original monument and accessories and/or subsequent restoration:

Corner set in 1823 by S. Sibley, County Surveyor, set post
White Oak 28" N 10½ W 1.24 chains
Black Oak 20" N 65 W 1.29 chains


2. Description of corner evidence found and/or method applied in restoring or reestablishing corner:

Found ½" iron rod in Mon. box, 1' South of Centerline Brighton Rd.
30 feet East of Centerline Chilson Rd.

P.A. 345 1990, APPROVED BY LIVINGSTON COUNTY
PEER GROUP ON 9-2-98 CO. REP JED

2. Description of monument for corner and accessories established to perpetuate locating the position of the corner:

Set 30" long by 1½" steel pipe with Brass cap stamped "Livingston
County Monumentation Corner"
S 77 E 185.37 set Remon N/T Southside power pole
S 02 N 25.20 set Remon N/T Northside power pole
N 42 W 145.78 set Remon N/T Westside power pole
S 30 E 187.0 North corner building

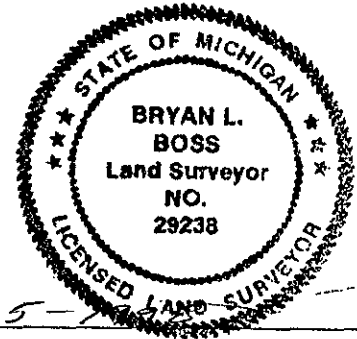

Signed by Bryan L. Boss

Date 10-15-98

Surveyor's Michigan License No. 29238