

OCT 26 1995

COMMISSION

LAND CORNER RECORDATION CERTIFICATE

Filing Requirement of Act 74, Mich. P.A. 1970

For corners in

Livingston
[County]

Located In:

Corner Code ~~==~~

1. Public Land Survey

T 2N__ R _5E_

I-7

2. Property Controlling in Section

S _____ T _____ R _____

3. Miscellaneous
Properly In Sec

S T R

4. Lot No. _____, Recorded Plat _____

5. Private Claims

I, Bryan Ross, in a field survey on 8-24, 19 95, do hereby certify that under requirements of P.A. 74, Michigan P.A. of 1970, the corner points mentioned in lines 1 and 2 above were in conformance with regulations and rules therefore as required in the current manual of survey instructions of the United States Department of the Interior, Bureau of Land Management or by a decree of a Court of Law and/or that the corner points mentioned in lines 3, 4 and 5 above were in conformance with the rules of the Michigan Board of Land Surveyors or by a Decree of a Court of Law; established, re-established, monumented, re-monumented, recovered, found as expressed below:

NOTE: Not more than 4 corners, all in the same town and range, may be recorded on this certificate.

A. Description of original monument and accessories and/or subsequent restoration:

Black Oak 14" N 56 E 112 links

Black Oak 16" N 56 W 96 links

Yellow Oak 13" N 21 3/4 E .91 chains miles Bullock

3. Description of corner evidence found and/or method applied in restoring or reestablishing corner:

Found 3/8" re-rod and cap #29230 in monument box.

Also found P.K. S $13^{\circ} 37' 10''$ E 0.68 feet of capped iron.

P.K. set by L.S. #21561 on 3-12-93.

39.00 N 51° E nail South side fence post

45.33 N 41° W nail West side pole

130.25 N 42° W Southeast corner of Genoa Township Hall

2. Description of monument for corner and accessories established to perpetuate locating the position of the corner:

Set brass cap on $\frac{1}{2}$ " iron in monument box


38.78 N 30°E nail & tag South side fence post

123.73 N 60° E nail & tag South side power pole

50.32 N 45° E nail & tag North side fence pos

150.95 S 5° W nail & tag North side power pole

46.28 N 45° W nail & tag South side power pole

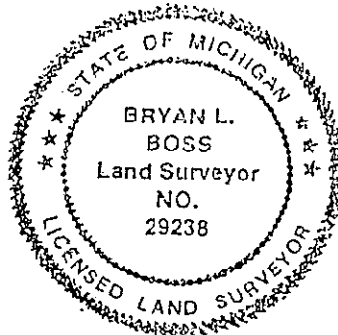

Signed by Robert H. Jones

Date Apr 28, 1995

Surveyor's Michigan License No. 29238

FORM APPROVED BY MICHIGAN STATE BOARD OF LAND SURVEYORS, JAN. 28, 1971
REVISED MAY 14, 1975
REVISED JAN., 1983

P.A. 345 1990, APPROVED BY LIVINGSTON COUNTY

PEER GROUP ON 2-1-95 CO. REP VED

SUMMARY


I-7

Northwest Corner, Section 23, T2N-R5E, Genoa Township, Livingston County, Michigan.

Found Boss capped iron in monument box 2 feet \pm East of centerline Dorr Road and 2 feet \pm North of centerline Crooked Lake Road. This corner is open to G.P.S.. Measured to witnesses found. Found P.K. nail set by Arvin Butterfield on 3-12-93, pages 27, 28 this dossier. Witness to Southeast Corner of Township Hall, 144.0 feet, made an abrupt change to 130.46 between 1978 and 4-16-83 (see pages 33 and 20) Arvin Butterfield survey and Act 74 (pages 27 and 28) show Boss Engineering capped iron in monumentation box to be 0.68 feet Northwest of P.K. Nail. Accepting the P.K. Nail 0.68 feet S $13^{\circ}37'10''$ E from Monumentation box will check with all existing surveys and previous witnesses (again see Act 74 - page 27) location.

Conclusion: We recommend removal of monument box and Boss Iron. This corner should be relocated and set per Arvin Butterfield's Act 74 certificate.

GENI-7S

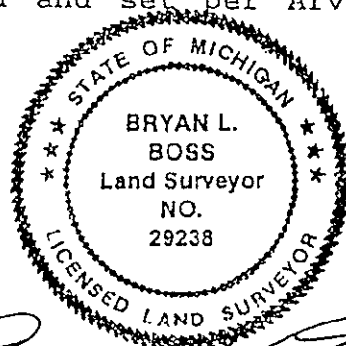

Bryan L. Boss