

DEC 29 11 25 AM '93

LAND CORNER RECORDATION CERTIFICATE
Filing Requirement of Act 74, Mich. P.A. 1970

NANCY HAVILAND
REGISTER OF DEEDS
LIVINGSTON COUNTY, MI
48843

For corners in

Livingston	Located In:	Corner Code #
1. Public Land Survey	T <u>2N</u> R <u>5E</u>	<u>K-12</u>
	T <u> </u> R <u> </u>	<u> </u>
	T <u> </u> R <u> </u>	<u> </u>
	T <u> </u> R <u> </u>	<u> </u>
2. Property Controlling in Section	S <u> </u> T <u> </u> R <u> </u>	<u> </u>
	S <u> </u> T <u> </u> R <u> </u>	<u> </u>
3. Miscellaneous	S <u> </u> T <u> </u> R <u> </u>	<u> </u>
Property in Sec.	S <u> </u> T <u> </u> R <u> </u>	<u> </u>
4. Lot No. <u> </u> , Recorded Plat <u> </u>		
5. Private Claims <u> </u>		

L.S.C. #168m
Register of Deeds Stamp & File Number

I, Bryan Boss, in a field survey on December 22, 19 93, do hereby certify that under requirements of P.A. 74, Michigan P.A. of 1970, the corner points mentioned in lines 1 and 2 above were in conformance with regulations and rules therefore as required in the current manual of survey instructions of the United States Department of the Interior, Bureau of Land Management or by a decree of a Court of Law and/or that the corner points mentioned in lines 3, 4 and 5 above were in conformance with the rules of the Michigan Board of Land Surveyors or by a Decree of a Court of Law; established, re-established, monumented, re-monumented, recovered, found as expressed below:

NOTE: Not more than 4 corners, all in the same town and range, may be recorded on this certificate.

A. Description of original monument and accessories and/or subsequent restoration:

Surveyed by Grant Dunning 1915

	A	B	C	D	E	F	G	H	I	J	K	L	M
2	6			5		4		3		2			
3													
4	7			8		9		10		11		12	
5													
6	18			17		16		15		14		13	
7													
8	19			20		21		22		23		24	
9													
10	30			29		28		27		26		25	
11													
12	31			32		33		34		35		36	
13													

SURVEY &
REMONUMENTATION

1993

COMMISSION

B. Description of corner evidence found and/or method applied in restoring or reestablishing corner:

Found 1/2" Rebar 6 Feet ± West of Centerline Bauer Road on Centerline of Cunningham Lake Road

C. Description of monument for corner and accessories established to perpetuate locating the position of the corner:


Reset with a 1 1/4" x 36" Breakaway Iron Pipe with Livingston Co. Brass Cap on Top

East 33.0' C/L 3" x 6" Concrete Filled Steel Post
N25°W 55.28' Spike W/Side 36" Oak
S35°W 44.02' Spike SE/Side 32" Oak
N45°E 40.64' Spike NW/Side Quad 12" Locust

Approved by Livingston Co. Monumentation Peer Group on December 1, 1993

Signed by

Surveyor's Michigan License No. 29238

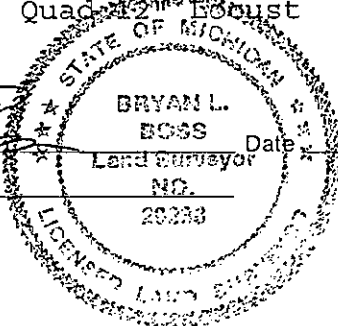

December 28, 1993

BOSS ENGINEERING
ENGINEERS & SURVEYORS

APPROVED

12-1-93

December 1, 1993

SUMMARY

K-12 West 1/4 Corner, Section 36, Genoa Township,
T2N-R5E, Livingston County, Michigan


Distance from W 1/4 corner to S. W. corner measures 2664.61.

Distance from W 1/4 corner to N. W. corner measures 2665.46.

Witnesses on 10-4-93 concur with Cunningham Trust Survey
page 10 and 1985 survey page 7.

Found 1/2" rerod centerline of Cunningham Lake Road West and
fence line to East. Also 6 feet +/- West of centerline of
Bauer.

File: REMON2

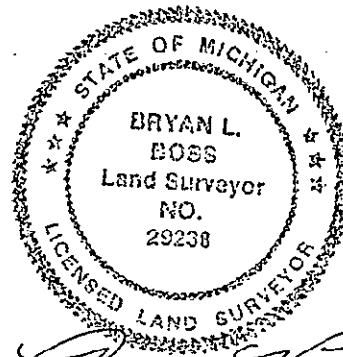

[Handwritten signature]