

SURVEY & REMONUMENTATION

JUN 01 1998

SECTION

LAND CORNER RECORDATION CERTIFICATE

Filing Requirement of Act 74, Mich. P.A. 1970

FILED

For corners in

LIVINGSTON
(County)

Located in:
GENOA TWP.

Corner Code: //

1998 MAY 29 P 1:44

NANCY HAVILAND
REGISTER OF DEEDS
LIVINGSTON COUNTY, MI.
48843

L.S.C.#843m

(See L.S.C.#830m) (c)
Register of Deeds Stamp & File Number

1 Public Land Survey

T R

T R

T R

T R

2. Properly Controlling
in Section

S T R

S T R

3 Miscellaneous
Property in Sec.

S T R

S T R

S 33 T 2N R 5E

003

4 Lot No

5 Private Claims

Recorded Plat

I, **BRYAN L. BOSS**, in a field survey on **NOVEMBER 3, 1997**, do hereby certify that under requirements of P.A. 74, Michigan P.A. of 1970, the corner points mentioned in lines 1 and 2 above were in conformance with regulations and rules therefore as required in the current manual of survey instructions of the United States Department of the Interior, Bureau of Land Management or by a decree of a Court of Law and/or that the corner points mentioned in lines 3, 4 and 5 above were in conformance with the rules of the Michigan Board of Land Surveyors or by a Decree of a Court of Law, established, re-established, monumented, re-monumented, recovered, found as expressed below

NOTE: Not more than 4 corners, all in the same town and range, may be recorded on this certificate.

A Description of original monument and accessions and/or subsequent restoration.


WHITE OAK 8" N 80 E 2.20 CHAINS.
NO OTHER TIMBER NEAR.

B Description of corner evidence found and/or method applied in restoring or reestablishing corner

THIS IS A LOST CORNER.
THE EXISTING CHILSON POND NOW COVERS THIS AREA.
RECOMMENDED SETTING REFERENCE MONUMENTS EAST AND ON
LINE WITH SOUTHWEST CORNER, SECTION 33 AT SPLIT DISTANCE.

C Description of monument for corner and accessions established to perpetuate locating the position of the corner

-003 OF 3
SET 1 1/4 X 38" PIPE WITH 6" BREAKOFF AND BRASS
CAP STAMPED "LIVINGSTON COUNTY MONUMENTATION WITNESS"
IN MONUMENT BOX IN CENTERLINE OF CHILSON ROAD.
N 30° E 43.33' N & T NW SIDE GATEPOST CORNER
S 85° E 27.57' N & T NORTH SIDE GATEPOST CORNER
S 30° W 89.55' N & T SE SIDE 26" MAPLE
N 85° W 50.81' N & T NORTH SIDE 10" TWIN LOCUST

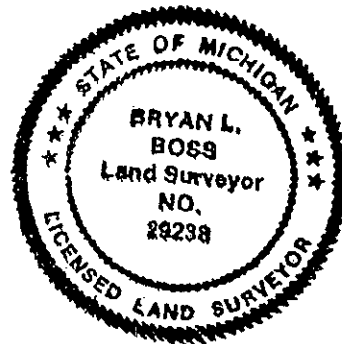

Surveyed by *Bryan L. Boss*
Surveyor of a Michigan License No. 29238

Date

May 28, 1998

PA 345 1990, APPROVED BY LIVINGSTON COUNTY

ON 9-3-97 CO. REP JED

FORM APPROVED BY MICHIGAN STATE BOARD OF LAND SURVEYORS, JAN. 28, 1993
REVISED MAY 14, 1975
REVISED JAN., 1943

SUMMARY
F-13

South 1/4 Corner, Section 33, Genoa Township.


In December 1815, Alex Holmes set post at 40 chains and recorded one witness.

On 9-17-1948, S.V. Higgins of the Department of Natural Resources surveyed from South 1/4 Corner and set 3/4" Inch pipes in creek and in Chilson Road.

A dam has been constructed between 1950 and the present, North of F-13 approximately 1300 feet \pm . The existing Chilson pond now covers this area and upstream into Section 4, Hamburg Township, about 1/2 mile.

This is now a lost corner.

We recommend setting reference monuments East and on line with the approved Southeast Corner of Section 33 and West and on line WITH the approved Southwest Corner Section 33, at the split distance. Bearings AND distances to be recorded on Act 74 with submission of dossier.

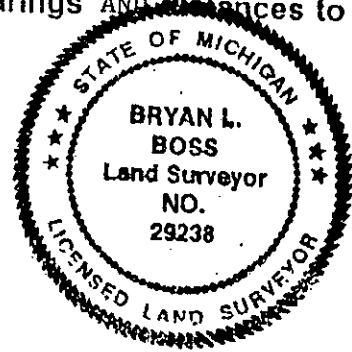

Bryan L. Boss