

LAND CORNER RECORDATION CERTIFICATE
Filing Requirement of Act 74, Mich. P.A. 1970

For corners in

Livingston
(County)

Located In:

Corner Code ##

1. Public Land Survey

T 3N R 3E

L-7

T R

T R

T R

2. Property Controlling
In Section

S T R

S T R

3. Miscellaneous
Property in Sec.

S T R

S T R

4. Lot No. , Recorded Plat

5. Private Claims

SEP 1 3 28 PM '94
NANCY HAVILAND
REGISTER OF DEEDS
LIVINGSTON COUNTY, MI
48843

FILED

L.S.C. # 241m

Register of Deeds Stamp & File Number

I, Charles E Garlock, in a field survey on August 18, 19 94,
do hereby certify that under requirements of P.A. 74, Michigan P.A. of 1970, the corner points mentioned
in lines 1 and 2 above were in conformance with regulations and rules therefore as required in the
current manual of survey instructions of the United States Department of the Interior, Bureau of Land
Management or by a decree of a Court of Law and/or that the corner points mentioned in lines 3, 4 and 5
above were in conformance with the rules of the Michigan Board of Land Surveyors or by a Decree of a
Court of Law; established, re-established, monumented, re-monumented, recovered, found as
expressed below:

NOTE: Not more than 4 corners, all in the same town and range, may be recorded
on this certificate.

A. Description of original monument and accessories and/or subsequent restoration:

GLO survey date: April 15, 1825, by S. Sibley

GLO witnesses: Sugar 11-N70E-0.14 ch

Sugar 9-S611/2W-0.19 ch

	A	B	C	D	E	F	G	H	I	J	K	L	M
2	6		5		4		3		2		1		
3													
4	7		8		9		10		11		12		
5													
6	18		17		16		15		14		13		
7													
8	19		20		21		22		23		24		
9													
10	30		29		28		27		26		25		
11													
12	31		32		33		34		35		36		
13													

See additional data on rear of sheet

B. Description of corner evidence found and/or method applied in restoring or reestablishing corner:

Found 1/2" I. Rod in ~~xxxxxx~~ median of I-96, NE'ly of E.B. I-96

SURVEY &
REMONUMENTATION

SEP 26 1994

COMMISSION

C. Description of monument for corner and accessories established to perpetuate locating the position of the corner:


L-7: North 1/4 cor. Sec. 24 T3N-R3E, Handy Twp. Liv.Co.MI., set 1 1/4" X 36" I. Pipe
with Liv. Co. Remon brass cap on top at -0.3'

N65W-32.30'-ctr. 1" Cedar

S50W-32.30'-nearest edge of concrete pvmt of E.B. I-96

N3W-66.20'-ctr. 2" Poplar

N60W-155.45'-"X" in top ctr. of 2' dia Conc pipe at North end

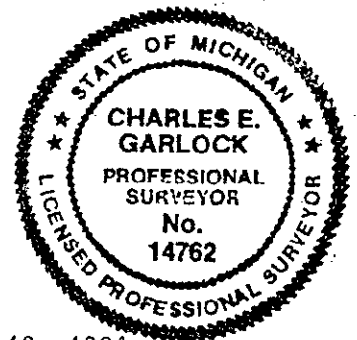

Signed by Charles E Garlock Date August 19, 1994

Surveyor's Michigan License No. 14762

CORNER SUMMARY
L-7: NORTH 1/4 CORNER OF SECTION 24, T3N-R3E, HANDY TOWNSHIP,
LIVINGSTON COUNTY, MICHIGAN.

GLO SURVEY DATED APRIL 25, 1825 BY S. SIBLEY AND FOUND NONE OF THE
GLO WITNESSES REMAIN.

NEXT KNOWN SURVEY ACTIVITY WAS BY E GRANT IN 1878 AND M BULLOCK IN
1892. CLAY GORDON FOUND BULLOCK'S IRON AND WITNESS TREE THE SAME
IN 1939. MDOT FOUND AN I. PIPE IN 1958 AT THE ROAD CROSSING
BEFORE THE E-WAY WAS BUILT, IN 1967 I FOUND A 1/2" I. ROD AS DID N
FAHRNER IN 1971, J ALBRIGHT IN THE 1970'S, BOSS ENGR-1979, L
BRYAN-1988 & 1991. ALL WITNESSES CHECKED EXCEPT L BRYAN HAD THE
WRONG SIZE DIA. PIPE AND MAY HAVE COPIED WRONG DISTANCES, DID NOT
FIND OTHER IRONS IN THE AREA OR ONE TO MATCH L BRYAN'S NOTES.
DISTANCES TO ADJACENT CORNERS VARIED: N 1/4 TO NE CORNER L BRYAN
HAD 2620.86, MDOT HAD 2620.73, BOSS HAD 2619.10, P BENTON HAD
2619.09 AND DETROIT EDISON HAD 2618.68. N 1/4 TO NW CORNER, L
BRYAN HAD 2624.31 AND BOSS HAD 2624.01. IN 1878 E GRANT MEASURED
NORTH 2633.4 FEET TO THE CENTER OF SECTION 13, L BRYAN MEASURED
2632.02 AND BOSS ENGR. MEASURED 2631.93. FOUND 1 ACT 74 RECORDED
BY N FAHRNER AND 5 ACT 132'S BY OTHERS. CORNER IS LOCATED IN THE
I-96 MEDIAN AND AT THE XING OF THE PROJECTED CENTERLINES OF THE
OLD COUNTY ROADS, TWO BEING ACTIVE TO THE NORTH AND EAST AND TWO
ABANDONED TO THE SOUTH AND WEST. AREA IS OPEN IN ALL DIRECTIONS
AND ABOUT 41 FEET SOUTH TO THE NEAREST EDGE OF PAVEMENT.

