

OCT 25 1993

LAND CORNER RECORDATION CERTIFICATE
Filing Requirement of Act 74, Mich. P.A. 1970

SEP 27 8 38 AM '93

COMMISSION

For corners in

Livingston

(County)

Located In:

Corner Code ##

NANCY HAVILAND
REGISTER OF DEEDS
LIVINGSTON COUNTY, MI
48843

1. Public Land Survey. T 3N R 3E M-13
T _____ R _____
T _____ R _____
T _____ R _____
2. Property Controlling S _____ T _____ R _____
in Section S _____ T _____ R _____
3. Miscellaneous S _____ T _____ R _____
Property in Sec. S _____ T _____ R _____
4. Lot No. _____, Recorded Plat _____
5. Private Claims _____

L.S.C.#10m

Register of Deeds Stamp & File Number

I, Charles E Garlock, in a field survey on September 22, 19 93,
do hereby certify that under requirements of P.A. 74, Michigan P.A. of 1970, the corner points mentioned
in lines 1 and 2 above were in conformance with regulations and rules therefore as required in the
current manual of survey instructions of the United States Department of the Interior, Bureau of Land
Management or by a decree of a Court of Law and/or that the corner points mentioned in lines 3, 4 and 5
above were in conformance with the rules of the Michigan Board of Land Surveyors or by a Decree of a
Court of Law; established, re-established, monumented, re-monumented, recovered, found as
expressed below:

NOTE: Not more than 4 corners, all in the same town and range, may be recorded
on this certificate.

- A. Description of original monument and accessories and/or subsequent restoration:
GLO witnesses to Township corner (M-13)
N37W-41ks-32" B0; S20W-121ks-30"W0

See reverse side for corner summary of reseach.

GLO notes dated: April 15, 1825, Sylvester Sibley

- B. Description of corner evidence found and/or method applied in restoring or reestablishing corner:
Found 3/4" I. Pipe in Mon. Box, 2.5 ft. South of centerline of Mason Rd.

- C. Description of monument for corner and accessories established to perpetuate locating the position of the corner:
Re-set with 1 1/4" X 36" I. Pipe with Liv. Co. Monumentation cap in Mon. Box found at -0.5'
S10E-88.24'-sp W/s 10" Poplar
N70W-56.65'-sp N/s Utility pole
N20E-98.93'-sp W/s 24" Maple
N75E-156.73'-sp S/s Utility pole
North-2.5'±-ctr. Mason Rd
West-2.0'±-ctr. Truhn Rd to South
West-10'±-ctr. Truhn Rod. to North

APPROVED by Livingston County
Monumentation Peer Group
July 21, 1993

Signed by

Date

9/23/93

Surveyor's Michigan License No.

14762

FORM APPROVED BY MICHIGAN STATE BOARD OF LAND SURVEYORS, JAN. 28, 1971
REVISED MAY 14, 1975
REVISED JAN., 1983

10/26/93

SERVING LIVINGSTON COUNTY
SINCE 1868

"Be Sure of Your Ground"

CHARLES E. GARLOCK

PROFESSIONAL SURVEYOR

840 EAST DAVIS ROAD
HOWELL, MICHIGAN 48843

OFFICE: (517) 546-3340

FAX: 517 546-2941


July 12, 1993

M-13: SE corner Section 36 Handy Twp. Liv. Co. Mi

Oldest known remaining witness is 1968 (L Munsell) and this corner agrees with a 1951 survey by C W Gordeon, in Marion Twp. Since 1951 all known surveys in each Township (Handy, Howell, Iosco and Marion) appear to be tied to the same geographically located corner. Also the average of two old old measures from the SE corner to the S 1/4 corner equals 40.24625 ch. (2656.25 ft.) and the current measure is 2656.18 ft. A sweep of the area found no additional irons and past survey records indicate that it is also a common Township corner.



Charles E Garlock, PS

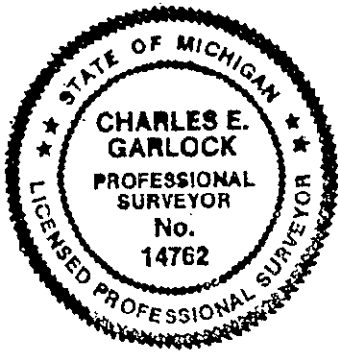

Found 3/4" pinched pipe in Mon. Box on Asphalt Road

SUCCESSOR TO:

MILES W. BULLOCK, L.S. (1844 TO 1926)

CLAY W. GORDON, RLS (1883 TO 1970)

GRANT H. DUNNING, P.E. (1865 TO 1928)

LYLE W. MUNSELL, RLS (1904 TO 1987)