

## CORNER SUMMARY

K-9: NORTHWEST CORNER SECTION 25, T3N-R4E, HOWELL TOWNSHIP,  
LIVINGSTON COUNTY, MICHIGAN.

GLO SURVEY DATED APRIL 15, 1825 BY S SIBLEY, DS, AND NONE OF THE  
GLO WITNESSES REMAIN.

M BULLOCK IN 1872 WITNESSED THIS CORNER AND HIS WITNESS IS GONE AS  
IS THAT OF G DUNNING IN 1915. C GORDON IN 1935 SET A WELL POINT  
AND TWO OF HIS WITNESSES REMAIN TODAY AND CHECK TO A FOUND 1/2" I.  
ROD. SINCE 1935 L MUNSELL, BENTON, BOSS, MUNZEL, THOMPSON AND  
MYSELF HAVE USED THE SAME CORNER AND MANY TIMES THE SAME TWO  
WITNESS TREES THAT C GORDON USED IN 1935 AND AT ABOUT THE SAME  
MEASURES. FOUND THREE ACT 74'S RECORDED AND EIGHT ACT 132'S.  
CORNER LINES WITH THE WEST ROAD FENCE TO THE NORTH, REMAINS OF A  
FENCE TO THE SOUTH AND ABOUT 3 FEET SOUTH OF THE GRAVEL CENTERLINE  
OF HENDERSON ROAD TO THE EAST AND WEST. SITE IS NOT GOOD FOR GPS.  
MEASURES EAST ARE 2614.92 BY OLD SURVEY RECORDS, 2648.00 BY GORDON  
AND 2646.35 BY MYSELF THIS YEAR. MEASURES SOUTH ARE 2658.10 BY  
BOSS AND 2671.02 BY OLD SURVEY RECORDS. MEASURE WEST IS 2643.93  
BY BENTON AND 1/2 THAT DISTANCE LINES WITH NORTH-SOUTH CENTERLINE  
OF ANN ARBOR RAILROAD. FOUND NO OTHER IRONS IN THE AREA AND  
RECOMMEND THE CONTINUED USE OF THE FOUND CORNER.



CHARLES E GARLOCK  
PS 14762  
HOW96K9

3N4E K9 4

LAND CORNER RECORDATION CERTIFICATE  
Filing Requirement of Act 74, Mich. P.A. 1970

For corners in

Livingston  
(County)

Located In:

Corner Code ##

1. Public Land Survey

T 3N R 4E K-10

T \_\_\_\_\_ R \_\_\_\_\_

T \_\_\_\_\_ R \_\_\_\_\_

T \_\_\_\_\_ R \_\_\_\_\_

2. Property Controlling  
in Section

S \_\_\_\_\_ T \_\_\_\_\_ R \_\_\_\_\_

S \_\_\_\_\_ T \_\_\_\_\_ R \_\_\_\_\_

3. Miscellaneous  
Property in Sec.

S \_\_\_\_\_ T \_\_\_\_\_ R \_\_\_\_\_

S \_\_\_\_\_ T \_\_\_\_\_ R \_\_\_\_\_

4. Lot No. \_\_\_\_\_, Recorded Plat \_\_\_\_\_

5. Private Claims \_\_\_\_\_

MAY 30 3 46 PM '96  
NANCY HAYLAND  
REGISTER OF DEEDS  
LIVINGSTON COUNTY, MI  
48843

L. S. C. #536m

Register of Deeds Stamp & File Number

I, Charles E Garlock, in a field survey on May 21, 1996,  
do hereby certify that under requirements of P.A. 74, Michigan P.A. of 1970, the corner points mentioned  
in lines 1 and 2 above were in conformance with regulations and rules therefore as required in the  
current manual of survey instructions of the United States Department of the Interior, Bureau of Land  
Management or by a decree of a Court of Law and/or that the corner points mentioned in lines 3, 4 and 5  
above were in conformance with the rules of the Michigan Board of Land Surveyors or by a Decree of a  
Court of Law; established, re-established, monumented, re-monumented, recovered, found as  
expressed below:

NOTE: Not more than 4 corners, all in the same town and range, may be recorded  
on this certificate.

A. Description of original monument and accessories and/or subsequent restoration:

GLO survey dated:.....April 15, 1825 by 'S Sibley

GLO witnessess.....W0 14-S23E-29 lks

W0 12-N1E-60 lks

SURVEY &  
REMONUMENTATION

AUG 06 1996

COMMISSION

Additional historical data on rear of sheet.


B. Description of corner evidence found and/or method applied in restoring or reestablishing corner:

Found 1" I. Rod inside 3/4" X 24" I Pipe

P.A. 345 1990, APPROVED BY LIVINGSTON COUNTY  
PEER GROUP ON 3-6-96, CO. REP JED

C. Description of monument for corner and accessories established to perpetuate locating the position of the corner:

K-10: W 1/4 cor. Sec. 25, T3N-R4E, Howell Twp. Liv. Co. MI. reset with 1 1/4" X 36"  
I. Pipe with Liv. Co. Remon brass cap at -0.2'  
S85E-116.33'-sp & tag N/s 10" hickory  
S10E-92.68'- sp & tag E/s 18" W Oak  
S50W-53.72'-sp & tag N/s 20" W Oak  
West-5.25'-back side of Conc. curb  
North-12.12'-backside of Conc. curb  
East-5.10'-backside of Conc. curb.

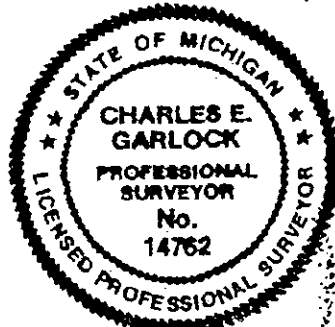

Signed by Charles E Garlock Date May 23, 1996

Surveyor's Michigan License No. 14762