

SURVEY & REMONUMENTATION

FEB 25 1999

FILED

LAND CORNER RECORDATION CERTIFICATE Filing Requirement of Act 74, Mich. P.A. 1970

for corners in SECTION

<u>LIVINGSTON</u> (County)	Located In:	Corner Code #
1. Public Land Survey	T <u> </u> R <u> </u>	<u> </u>
	T <u> </u> R <u> </u>	<u> </u>
	T <u> </u> R <u> </u>	<u> </u>
	T <u> </u> R <u> </u>	<u> </u>
2. Property Controlling in Section	S <u> </u> T <u> </u> R <u> </u>	<u> </u>
	S <u> </u> T <u> </u> R <u> </u>	<u>004</u>
3. Miscellaneous Property in Sec.	S <u>11/14</u> T <u>3N</u> R <u>5E</u>	<u>004</u>
	S <u> </u> T <u> </u> R <u> </u>	<u> </u>

1998 OCT 20 P 1:21

NANCY HAVILAND
REGISTER OF DEEDS
LIVINGSTON COUNTY, MI.
48843

LSC 922M

Register of Deeds Stamp & File Number

4. Lot No. , Recorded Plat
5. Private Claims

I, MARY A. BARNWELL, in a field survey on AUGUST 17, 1998, do hereby state that under requirements of P.A. 74, Michigan P.A. of 1970, the corner points mentioned in lines 1 and 2 above were in conformance with regulations and rules therefore as required in the current manual of survey instructions of the United States Department of the Interior, Bureau of Land Management, or by a decree of a Court of Law and/or that the corner points mentioned in lines 3, 4 and 5 above were in conformance with the rules of the Michigan Board of Land Surveyors or by a Decree of a Court of Law; established, re-established, monumented, recovered, found as expressed below:

NOTE: Not more than 2 corners, all in the same town and range, may be recorded on this certificate.

1	A	B	C	D	E	F	G	H	I	J	K	L	M
2		6		5		4		3		2		1	
3													
4		7		8		9		10		11		12	
5													
6		18		17		16		15		14		13	
7													
8		19		20		21		22		23		24	
9													
10		30		29		28		27		26		25	
11													
12		31		32		33		34		35		36	
13													

A. Description of original monument and accessories and/or subsequent restoration:

THE GLO DID NOT SET THIS CORNER BECAUSE IT FELL IN A POND

B. Description of corner evidence found and/or method applied in restoring or reestablishing corner:

COMPUTED A POSITION EQUIDISTANT TO I-05 AND K-05 ON A LINE EXTENDED WESTERLY FROM K-05 THROUGH A FOUND IRON AND FENCE CORNER AS SHOWN ON BOSS ENGINEERING SURVEY #89492. (NOTE: THIS POSITION FOR J-05 FALLS 0.37 FEET EAST AND 19.63 FEET SOUTH OF THE BOSS ENGINEERING COMPUTED LOCATION AS SHOWN ON THE ABOVE - REFERENCED DRAWING).

C. Description of monument for corner and accessories established to perpetuate locating the position of the corner:


004 (1 OF 2) NORTHERLY ACCESSORY WITNESS FOR THE SOUTH 1/4 CORNER SECTION 11, NORTH 1/4 CORNER SECTION 14, T3N, R5E OCEOLA TOWNSHIP, LIVINGSTON COUNTY, MICHIGAN: SET 1" X 36" STEEL PIPE WITH LIVINGSTON COUNTY REMONUMENTATION WITNESS CORNER BRASS CAP WITH SURVEYOR #35999 DISTANT 400.00 FEET NORTHERLY OF J-05.

N07°W	NAIL WITH LIVINGSTON COUNTY REMON TAG IN WEST SIDE 10" CHERRY	26.45'
S55°E	NAIL WITH LIVINGSTON COUNTY REMON TAG IN NORTH SIDE 9" CHERRY	49.02'
N52°E	NAIL WITH LIVINGSTON COUNTY REMON TAG IN WEST SIDE 20" DOUBLE OAK	27.35'
EAST	NAIL WITH LIVINGSTON COUNTY REMON TAG IN NORTH SIDE 24" OAK	55.52'

Signed by Mary A. Barnwell

Date 10/1/98

Surveyor's Michigan License No. 33971

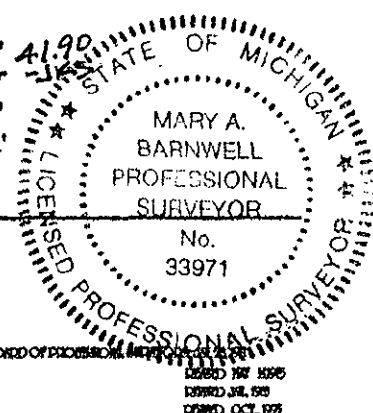

NOT AFFORDED BY MICHIGAN STATE BOARD OF PROFESSIONAL SURVEYORS
 EXPIRED JAN. 1995
 EXPIRED JUL. 1995
 EXPIRED OCT. 1995

P.A. 345 1980, APPROVED BY LIVINGSTON COUNTY

PEER GROUP ON 8-5-98 CO. REP VED