

FEB 24 1998

SECTION

LAND CORNER RECORDATION CERTIFICATE
Filing Requirement of Act 74, Mich. P.A. 1970

FILED

For corners in

LIVINGSTON
(County)

Located In:

Corner Code #

- | | | | | | |
|------------------------------------|---|----|---|----|------|
| 1. Public Land Survey | T | 3N | R | 6E | D-13 |
| | T | | R | | |
| | T | | R | | |
| | T | | R | | |
| 2. Property Controlling in Section | S | | T | R | |
| | S | | T | R | |
| 3. Miscellaneous Property in Sec. | S | | T | R | |
| | S | | T | R | |

1997 NOV 13 P 1:44
NANCY HAVILAND
REGISTER OF DEEDS
LIVINGSTON COUNTY, MI.
48843

L.S.C.#799m

Register of Deeds Stamp & File Number

4. Lot No. _____, Recorded Plat _____
5. Private Claims _____

I, Jack K. Smith, in a field survey on July 20, 1997 do hereby state that under requirements of P.A. 74, Michigan P.A. of 1970, the corner points mentioned in lines 1 and 2 above were in conformance with regulations and rules therefore as required in the current manual of survey instructions of the United States Department of the Interior, Bureau of Land Management or by a decree of a Court of Law and/or that the corner points mentioned in lines 3, 4 and 5 above were in conformance with the rules of the Michigan Board of Land Surveyors or by a Decree of a Court of Law; established, re-established, monumented, recovered, found as expressed below:

NOTE: Not more than 2 corners, all in the same town and range, may be recorded on this certificate.

A	B	C	D	E	F	G	H	I	J	K	L	M
1												
2	6		5		4		3		2		1	
3												
4	7		8		9		10		11		12	
5												
6	18		17		16		15		14		13	
7												
8	19		20		21		22		23		24	
9												
10	30		29		28		27		26		25	
11												
12	31		32		33		34		35		36	
13												


A. Description of original monument and accessories and/or subsequent restoration:

D-13 The South 1/4 Corner of Section 32, Hartland Township was set by Alex Holmes for the GLO in 1816.
The original witnesses are:
W Oak 20" N73°E 31 lk (20.5')
Aspen 8" S50°W 29 lk (19.1')

NOTE: NONE OF THE ORIGINAL WITNESSES COULD BE FOUND OR PERPETUATED.
SEE THE BACK OF THIS SHEET FOR ADDITIONAL HISTORICAL DATA.

B. Description of corner evidence found and/or method applied in restoring or reestablishing corner:

D-13 Found 3/4" steel pipe with Cap #19826.

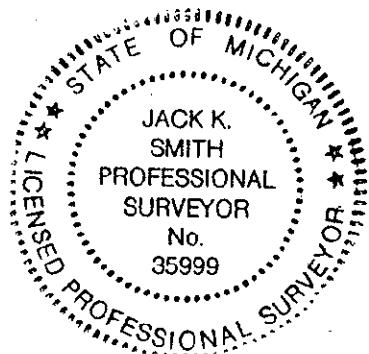

C. Description of monument for corner and accessories established to perpetuate locating the position of the corner:

D-13 South 1/4 Corner, Section 31, T3N, R6E - Set 1 1/4" x 36" steel pipe with brass cap marked as "Livingston County Remonumentation Corner".

NORTH	Set nail/tag in East side 16" Hickory	13.15'
N46°W	Set nail/tag in NE side 18" Hickory	36.81'
N71°E	Set nail/tag in South side 20" Hickory	22.34'
S32°E	Set nail/tag in NE side Triple 16" Oak	35.47'

Signed by Jack K. Smith
Surveyor's Michigan License No. 35999

Date July 20, 1997

May 5, 1997

D-13 T3N - R6E: SOUTH 1/4 CORNER, SECTION 32, HARTLAND TOWNSHIP

MONUMENTATION

We found a 3/4" pipe with Pat Benton's cap about 50 feet south of a private 2 track drive and about 500 feet west of a farm gate at the start of the drive. The corner was originally recorded as being set by Alex Holmes in 1816. This corner was supposed to be found and reset by Dunning in 1920. Boss shows a set iron in a 1972 Act 74 by occupation but there is a Pat Benton pipe at the corner now. All of the Boss witnesses from 1972 still check.

MEASUREMENTS

Current measure is 2652.23 feet to the west, 2652.74 feet to the east and 2684.06 feet to the north. Previous measures to north, east and west compare well.

OCCUPATION

The corner looks like it is about 7 feet south of a slight mounded area with stones and very scattered fence remains, but it is hard to really define a line. there is fence well to the north but I could not see it from the corner position. A sweep of the area did not reveal any additional irons and there was no evidence that any other corner position has been used.


This corner can not be used for GPS due to trees.

RECORDATION

There is an Act 74 filed by Oscar Boss from 1972 and the corner has been shown on 6 Act 132s.

SUMMARY

The iron that exists has been used for surveys in the area in recent years and would appear to match fairly well with occupation, therefore I recommend acceptance of the current pipe for the location of E-13.

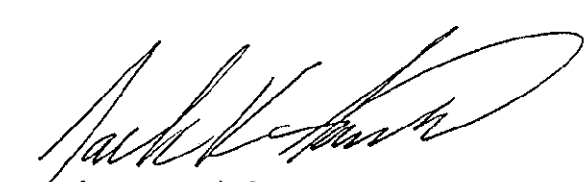
Jack K. Smith, PS
Desine Inc.

