

SURVEY &
REMONUMENTATION

DEC 07 1994

COMMISSION

LAND CORNER RECORDATION CERTIFICATE
Filing Requirement of Act 74, Mich. P.A. 1970

FILED
SEP 15 8 58 AM '94
NANCY HAVILAND
REGISTER OF DEEDS
LIVINGSTON COUNTY, MI
48843

For corners in

LIVINGSTON
(County)

Located In:

Corner Code #

1. Public Land Survey T 3N R 6E I-11
T R
T R
T R
2. Property Controlling S T R
In Section S T R
3. Miscellaneous S T R
Property in Sec. S T R

L.S.C. #263m

Register of Deeds Stamp & File Number

4. Lot No. , Recorded Plat
5. Private Claims

	A	B	C	D	E	F	G	H	I	J	K	L	M
2	6		5		4		3		2				
3													
4	7		8		9		10		11		12		
5													
6	18		17		16		15		14		13		
7													
8	19		20		21		22		23		24		
9													
10	30		29		28		27		26		25		
11													
12	31		32		33		34		35		36		
13													

Jack K. Smith, in a field survey on September 4, 1994, do hereby certify that under requirements of P.A. 74, Michigan P.A. of 1970, the corner points mentioned in lines 1 and 2 above were in conformance with regulations and rules therefore as required in the current manual of survey instructions of the United States Department of the Interior, Bureau of Land Management or by a decree of a Court of Law and/or that the corner points mentioned in lines 3, 4 and 5 above were in conformance with the rules of the Michigan Board of Land Surveyors or by a Decree of a Court of Law; established, re-established, monumented, re-monumented, recovered, found as expressed below:

NOTE: Not more than 4 corners, all in the same town and range, may be recorded on this certificate.

A. Description of original monument and accessories and/or subsequent restoration:

I-11 The Southwest Corner of Section 26, Hartland Township was set by the GLO in 1823 by S. Sibley.
The original witnesses are:
Aspen 16" S32W 11 lks
Aspen 14" N03E 10 lks

NOTE: NONE OF THE ORIGINAL WITNESSES COULD BE FOUND OR PERPETUATED
SEE THE BACK OF THIS SHEET FOR ADDITIONAL HISTORICAL DATA.

B. Description of corner evidence found and/or method applied in restoring or reestablishing corner:

I-12 Found 1 1/2" x 14" iron pipe on the south edge of a 2-track lane, 10 feet ± north of the north side of a drainage ditch. There are remnants of an old fence to the north.



C. Description of monument for corner and accessories established to perpetuate locating the position of the corner:

I-11 Southwest corner, Section 26, T3N, R6E
Set 36" x 1 1/4" iron pipe with brass cap marked as "Livingston County Monument Corner"
N10°W Nail and tag in E side 22" Maple 34.25'
S45°E Nail and tag in SW side 18" Maple 54.21'
S45°W Nail and tag in NW side 15" Hickory 41.40'
N40°W Nail and tag in NE side 10" Maple 30.55'

Signed by Date September 10, 1994

Surveyor's Michigan License No. 35999

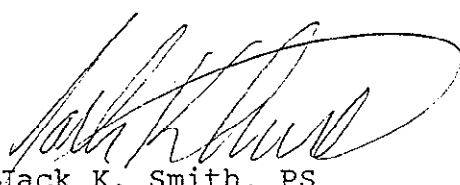
PA 345 1990, APPROVED BY LIVINGSTON COUNTY
FEE GROUP ON 9 APR 94 CO. REP

FORM APPROVED BY MICHIGAN STATE BOARD OF LAND SURVEYORS, JAN. 28, 1971
REVISED MAY 14, 1975
REVISED JAN., 1983

March 12, 1994

I-11, T3N, R6E: NORTHWEST CORNER, SECTION 35, HARTLAND TOWNSHIP

Found 1 1/2" X 14" Iron Pipe on the south edge of a 2-track lane, 10 feet \pm north of the north side of a drainage ditch. There are remnants of old fence running to the north but no well defined east-west fenceline. The corner was originally set by Sibley in 1823. The minutes for the Hartland County Drain of 1907 call for the drain to be 30 links (19.8 feet) south of the corner which fits within reason with the present location. Notes of Clay Gordon show partitioning of the section but his distances don't match up well with subsequent surveys along the North line. Boss Engineering surveyed Section 35 in 1988, and their distances along the North line match within reason with present measure. Brad Thompson surveyed the Northwest 1/4 of Section 35, and matched our measure within .05 feet. A sweep of the area found no additional irons. I recommend accepting I-11, the Northwest Corner of Section 35, at the location as is presently monumented.


Jack K. Smith, PS
Desine Inc.

