

1993

COMMISSION

LAND CORNER RECORDATION CERTIFICATE  
Filing Requirement of Act 74, Mich. P.A. 1970

For corners in

LIVINGSTON  
(County)

Located In:

Corner Code ##

1. Public Land Survey T 3N R 6E K-11  
T R  
T R  
T R  
2. Property Controlling S T R  
in Section S T R  
3. Miscellaneous S T R  
Property in Sec. S T R

L.S.C. #151m

Register of Deeds Stamp & File Number

DEC 28 4 35 PM '93  
NANCY HAVILAND  
REGISTER OF DEEDS  
LIVINGSTON COUNTY, MI  
48843

FILED

4. Lot No. , Recorded Plat  
5. Private Claims

	A	B	C	D	E	F	G	H	I	J	K	L	M
2	6		5		4		3		2		1		
3													
4	7		8		9		10		11		12		
5													
6	18		17		16		15		14		13		
7													
8	19		20		21		22		23		24		
9													
10	30		29		28		27		26		25		
11													
12	31		32		33		34		35		36		
13													

MARY A. BARNWELL

I, in a field survey on DECEMBER 6, 19 93, do hereby certify that under requirements of P.A. 74, Michigan P.A. of 1970, the corner points mentioned in lines 1 and 2 above were in conformance with regulations and rules therefore as required in the current manual of survey instructions of the United States Department of the Interior, Bureau of Land Management or by a decree of a Court of Law and/or that the corner points mentioned in lines 3, 4 and 5 above were in conformance with the rules of the Michigan Board of Land Surveyors or by a Decree of a Court of Law; established, re-established, monumented, re-monumented, recovered, found as expressed below:

NOTE: Not more than 4 corners, all in the same town and range, may be recorded on this certificate.

A. Description of original monument and accessories and/or subsequent restoration:

K-11 The Northwest Corner of Section 36, Hartland Township was set by the GLO in 1815 by Joseph Wampler.

The original witnesses are:

W. Oak 12" S41W 49 lks  
W. Oak 16" EAST 93 lks

NOTE: NONE OF THE ORIGINAL WITNESSES COULD BE FOUND OR PERPETUATED  
SEE THE BACK OF THIS SHEET FOR ADDITIONAL HISTORICAL DATA.

B. Description of corner evidence found and/or method applied in restoring or reestablishing corner:

K-11 Found 1/2" iron rod in the centerline of Lone Tree Road to the east, and Pleasant Valley Road to the north and south.

NOTE : SEE THE DOSSIER AS FILED FOR THE LIVINGSTON COUNTY  
REMONUMENTATION PROGRAM FOR ADDITIONAL INFORMATION  
CONCERNING THIS CORNER.

C. Description of monument for corner and accessories established to perpetuate locating the position of the corner:


Northwest Corner, Section 36, T3N, R6E

Set 30" x 1 1/4" iron pipe with 6" break-off pipe and brass cap marked as "Livingston County Monument Corner"

S70°W Nail and tag in NW side 12" Beech 37.15'  
N58°W Nail and tag in SW side 12" Oak 38.74'  
N38°E 36" x 1" iron pipe with brass "Witness" cap 43.72'  
S36°E 36" x 1" iron pipe with brass "Witness" cap 42.84'

APPROVED BY THE LIVINGSTON COUNTY MONUMENTATION PEER GROUP OCT. 30 1993.

Signed by  
Surveyor's Michigan License No. 33971

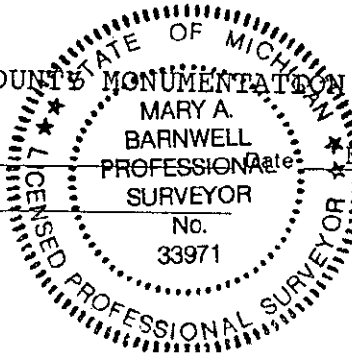

FORM APPROVED BY MICHIGAN STATE BOARD OF LAND SURVEYORS, JAN. 28, 1971  
REVISED MAY 14, 1975  
REVISED JAN., 1983

October 30, 1993

K-11, T3N, R6E: NORTHWEST CORNER, SECTION 36, HARTLAND TOWNSHIP

Found 1/2" Iron Rod at approximate centerline intersection of gravel roads going north, east and south. No occupation to the west. The terrain is gently rolling to the east, and is rolling and treed to the south. The only Survey of record is that by Boss in 1988 which uses the iron. A sweep of the area found no additional irons. I recommend accepting the Northwest Corner at the location as is presently monumented.

  
Mary A. Barnwell, PS  
Desine Inc.

