

MAR 17 2000

FILED

SECTION

LAND CORNER RECORDATION CERTIFICATE  
Filing Requirement of Act 74, Mich. P.A. 1970

1999 JUL 29 P 12:28

NANCY HAVILAND  
REGISTER OF DEEDS  
LIVINGSTON COUNTY, MI.  
48843

For corners in

LIVINGSTON

(County)

Located In:

Corner Code #

1. Public Land Survey

T R  
T R  
T R  
T R  
S T R  
S T R  
S 27 T 3N R 6E  
S T R

2. Property Controlling  
in Section

3. Miscellaneous  
Property in Sec.

4. Lot No. , Recorded Plat  
5. Private Claims

cls# 1049m

Register of Deeds Stamp & File Number

I, CHARLES E GARLOCK, in a field survey on MAY 11, 19 99 do hereby state that under requirements of P.A. 74, Michigan P.A. of 1970, the corner points mentioned in lines 1 and 2 above were in conformance with regulations and rules therefore as required in the current manual of survey instructions of the United States Department of the Interior, Bureau of Land Management or by a decree of a Court of Law and/or that the corner points mentioned in lines 3, 4 and 5 above were in conformance with the rules of the Michigan Board of Land Surveyors or by a Decree of a Court of Law; established, re-established, monumented, recovered, found as expressed below:

NOTE: Not more than 2 corners, all in the same town and range, may be recorded on this certificate.

	A	B	C	D	E	F	G	H	I	J	K	L	M
1													
2	6		5		4		3		2		1		
3													
4	7		8		9		10		11		12		
5													
6	18		17		16		15		14		13		
7													
8	19		20		21		22		23		24		
9													
10	30		29		28		27		26		25		
11													
12	31		32		33		34		35		36		
13													

A. Description of original monument and accessories and/or subsequent restoration:

GLO SURVEY DATED: MAY 24, 1823 BY S. SIBLEY

GLO NOTES: "COR SECS 27, 28, 33 & 34 IN LAKE, NO POST OR BEARINGS"

B. Description of corner evidence found and/or method applied in restoring or reestablishing corner:

G-11: IS LOCATED ON THE EXTENSION OF THE LINE FROM H-11 THROUGH EXISTING FOUND 1" PIPE. SAID 1" PIPE IS LOCATED 2003.07 FEET WEST OF H-11 AND 637.99 FEET EAST OF G-11. EAST-WEST DISTANCE OF G-11 WAS DETERMINED BY PRORATION OF GLO DISTANCES FROM E-11 TO H-11

C. Description of monument for corner and accessories established to perpetuate locating the position of the corner:


1" X 36" PIPE SET AT LOCATION OF FOUND 1" PIPE NEAR EAST SHORE OF LONG LAKE, SAID PIPE IS LOCATED 2003.07 FEET WEST OF H-11 ON THE SECTION LINE BETWEEN SECTIONS 27 AND 34 AND HAS A LIVINGSTON COUNTY REMON. BRASS CAP #14762 (BRASS WITNESS CAP)  
SOUTH-8.80'-SP & TAG E/S 7" ASH  
S45W-19.79'-SP & TAG N/S 8" WILLOW  
N15E-50.63'-SP & TAG W/S 5" CEDAR  
N45E-40.31'-SP & TAG S/S 10" ASH  
EAST- 2003.07 FT. TO H-11  
WEST-637.99 FT. TO G-11

Signed by

*Charles E. Garlock*

Date MAY 25, 1999

Surveyor's Michigan License No. 14762

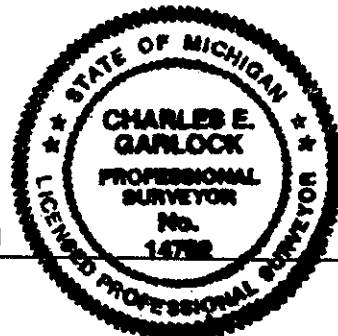

P.A. 345 1990, APPROVED BY LIVINGSTON COUNTY

PEER GROUP ON 5-5-1999 CO. REP JED