

# SURVEY & REMONUMENTATION

FEB 25 1999

SECTION

1998 REMONUMENTATION PROGRAM

LAND CORNER RECORDATION CERTIFICATE

Filing Requirement of Act 74, Mich. P.A. 1970

FILED

1998 OCT 14 P 2:11

NANCY HAVILAND  
REGISTER OF DEEDS  
LIVINGSTON COUNTY, MI.  
48843

LSC 910M

Register of Deeds Stamp & File Number

For corners in

Livingston  
(County)

Located In:

Corner Code #

- |                         |   |    |   |    |      |
|-------------------------|---|----|---|----|------|
| 1. Public Land Survey   | T | 4N | R | 4E | K-10 |
|                         | T |    | R |    |      |
| 2. Property Controlling | S |    | T |    |      |
| in Section              | S |    | T |    |      |
| 3. Miscellaneous        | S |    | T |    |      |
| Property in Sec.        | S |    | T |    |      |

4. Lot No. \_\_\_\_\_, Recorded Plat \_\_\_\_\_
5. Private Claims \_\_\_\_\_

I, John H. Rauser, P.S., in a field survey on September 1998  
do hereby certify that under requirements of P.A. 74, Michigan P.A. of 1970, the corner points mentioned  
in lines 1 and 2 above were in conformance with regulations and rules therefore as required in the  
current manual of survey instructions of the United States Department of the Interior, Bureau of Land  
Management or by a decree of a Court of Law and/or that the corner points mentioned in lines 3, 4 and 5  
above were in conformance with the rules of the Michigan Board of Land Surveyors or by a Decree of a  
Court of Law; established, re-established, monumented, re-monumented, recovered, found as  
expressed below:

NOTE: Not more than 2 corners, all in the same town and range, may be recorded  
on this certificate.

A. Description of original monument and accessories and/or  
subsequent restoration:

K-10 Common 1/4 Corner, Sections 25, & 26, T4N-R4E, Cohoctah Township, Livingston County

1823 Wood post placed by John Mullett, D.S.: W. Oak 16" S01E 8.63 lks  
Elm 18" S71.5W 588 lks

(Additional information on back)

PA 345 1990, APPROVED BY LIVINGSTON COUNTY

PEER GROUP ON 7-15-98 CO. REP JED

B. Description of corner evidence found and/or method applied in restoring or reestablishing corner:

K-10 Common 1/4 Corner, Sections 25, & 26, T4N-R4E, Cohoctah Township, Livingston County

Fnd no evidence of original government corner. Found a railroad spike in the East face of a 48" Ash tree. Found all of the  
1997 witnesses stated above. Found no other object in the vicinity of this corner.

C. Description of monument for corner and accessories established to perpetuate locating the position of the corner:

K-10 Common 1/4 Corner, Sections 25, & 26, T4N-R4E, Cohoctah Township, Livingston County


R/R spike in E fc 48" Ash tree, set two Standard Livingston County Remon iron pipes with witness caps 1/2' out of ground;  
one being 10.00' North of corner & one being 10.00' South of corner on the section line between Sections 25 & 26, T4N-  
R4E.

Witnesses for R/R spike in Ash tree

- N05E 10.00' Standard Livingston County Remon iron pipe with brass witness cap on section line with K-9  
South 10.00' Standard Livingston County Remon iron pipe with brass witness cap on section line with K-11  
N46E 30.20' Set remon tag in SE fc 6" Elm  
N29W 25.59' Fnd nail in NE fc 10" Elm  
S88E 24.85' Boss 1/2" traverse iron

(Continued on Back)

Signed by John H. Rauser  
Surveyor's Michigan License No. 39096

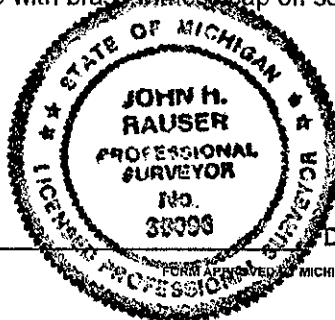

Date 9/30/98