

DEMONUMENTATION

OCT 26 1995

FILED

COMMISSION

LAND CORNER RECORDATION CERTIFICATE
Filing Requirement of Act 74, Mich. P.A. 1970

SEP 15 12 02 PM '95

For corners in Livingston
(County)

Located In:

Corner Code #

NANCY HAVILAND
REGISTER OF DEEDS
LIVINGSTON COUNTY, MI
48843

1. Public Land Survey T4N R 5E M-5
T R
T R
T R
2. Property Controlling S T R
in Section S T R
3. Miscellaneous S T R
Property in Section S T R

L.S.C.# 428m

Register of Deeds Stamp & File Number

4. Lot No. , Recorded Plat
5. Private Claims

	A	B	C	D	E	F	G	H	I	J	K	L	M
2	6		5		4		3		2				
3													
4	7		8		9		10		11		12		
5													
6	18		17		16		15		14		13		
7													
8	19		20		21		22		23		24		
9													
10	30		29		28		27		26		25		
11													
12	31		32		33		34		35		36		
13													

I, Edward Anderson, in a field survey on July 28, 1995,
do hereby certify that under requirements of P.A. 74, Michigan P.A. of 1970, the corner points mentioned
in lines 1 and 2 above were in conformance with regulations and rules therefore as required in the current
manual of survey instructions of the United States Department of the Interior, Bureau of Land
Management or by a decree of a Court of Law and/or that the corner points mentioned in lines 3, 4 and
5 above were in conformance with the rules of the Michigan Board of Professional Surveyors or by a
Decree of a Court of Law; established, re-established, monumented, re-monumented, recovered, found
as expressed below:

NOTE: Not more than 4 corners, all in the same town and range, may be recorded
on this certificate.

A. Description of original monument and accessories and/or subsequent restoration:

GLO NOTES DATED May 11, 1823
GLO WITNESSES Elm 12" N3°E 224 Lks
Tamarack S33°E 186 Lks

ADDITIONAL HISTORICAL DATA ON BACK


B. Description of corner evidence found and/or method applied in restoring or reestablishing corner:

RESET LOCATION OF PIKE "T" IRON USING WITNESSES

C. Description of monument for corner and accessories established to perpetuate locating the position of the corner:

M-5 N.E. COR. SEC 13 T4N-R5E
Set 1 1/4" x 36" iron pipe with Brass Cap (Liv. Co. Mon. Cor. under
propane tank 30' west of house
N72°E 26.45' N.W. corner house foundation
S54°E 30.45' S.W. corner house foundation
S72°W 18.00" spike N/S 8" Poplar
N73°W 59.62' spike S/S 36" Elm

Signed by Edward Anderson
Surveyor's Michigan License No. 11495

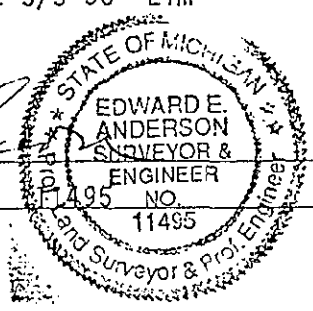

Date August 22, 1995

SUMMARY

August 22, 1995

M-5 N.E. CORNER SECTION 13, T4N-R5E, DEERFIELD TOWNSHIP
LIVINGSTON COUNTY, MICHIGAN

Found capped 1/2" rerod (Boss Engineering). I also reestablished the location of a point that was used by Pike Engineering as the N.E. corner of said Section 13, from Pikes witnesses, page 19 this dossier. Also, I found an old T-iron about 6" above ground, which was used by Cornerstone Engineering as the N.E. corner of said Section 13, page 28 this dossier. The Boss iron we found is in approximately the same location as the iron that was set (but now is gone) by Consumers Power as the N.E. corner of said Section 13. Also, see pages 39 and 40 this dossier as to the relationship of these corners to each other.

Checked and measured to witnesses we found. Found all of Cornerstone witnesses, and they checked to the T-iron we found. Found all of Boss witnesses, and they checked to 1/2" capped iron (Boss we found. Found all of Pikes witnesses, and we reset the location of his N.E. corner of said Section 13 by using the two witnesses to the house.

We found three of four of Consumers Power witnesses and the two witnesses from the house and to the closing corner to the north measure very close to the Boss iron we found. See pages 10, 11, 19, 20, 28, 31, 37, 39, and 40 this dossier.

The distance from the N.E. corner to the East 1/4 corner of said Section 13 will be 2653.7' depending on which location of the N.E. corner of said Section 13 is approved by the Livingston Co. Remonumentation Peer Group.

The distance from the N.E. corner to the North 1/4 corner of said Section 13 is 2682.09', Consumers Power Survey, page 10 and 37, this dossier, and 2679.45' Pike's survey, pages 16 and 17 this dossier, and 2671.11' Cornerstone survey, page 28 this dossier; and 2684.81' Boss surveys and computation sheets, pages 29, 30, 32, 33, 34, and 35 this dossier.

Made a clean sweep of immediate area and found no other corners or irons.

No occupation or old evidence of corner location in any direction, except the old T-iron found by myself, Boss and Cornerstone, and used by Cornerstone as the N.E. corner of said Section 13.

Terrain is open to the East and wooded to the west. House to the east.

Area is not good for G.P.S.

In conclusion, the old T-iron previously mentioned (that I found) falls 7.85' east of a straight line between the East 1/4 corner of Section 12, T4N-R5E, and the S.E. corner of Section 13, T4N-R5E. The capped iron set by Boss in the approximate same location as the corner set by Consumers Power and called the N.E. corner of said Section 13 by both Boss and Consumers, was set by running a straight line between the east 1/4 corner of said Section 12, and the closing corner at the S.W. corner of Section 7, T4N-R6E, and extending this line the G.L.O. distance to the south, pages 5, 9, 33, 34, 35, 37, 39, and 40, this dossier.

The Boss iron falls 21.69' east of a straight line between the East 1/4 corner of said Section 12 and the S.E. corner of said Section 13.

Pike says that he found a T-iron (now gone) at the N.E. corner of said Section 13. The location of Pikes N.E. falls 14.87' east of a straight line between the East 1/4 corner of said Section 12 and the S.E. corner of said Section 13, pages 19, 39, and 40 this dossier.

We know that the old T-iron we found was there previous to the time that Boss set their iron. Pike says he found a T-iron (which is now gone) at the location he used for the N.E. corner of said Section 13. Also, Consumers Power said they set a T-iron at the same location as where the Boss 1/2" capped rod is that we found.

The T-iron that we found and that was used by Cornerstone is the closest to the line between the East 1/4 corner of said 12 and the S.E. corner of said 13.

All of the above is a summary of the situation that exists at the location of the N.E. corner of said Section 13, and it was determined by the Livingston County Monumentation Peer Group on July 19, 1995, that the correct location of the N.E. corner of said Section 13 is at the location of the iron that Pike found (as mentioned above).

Edward E. Anderson
PS#1 5

STATE OF MICHIGAN
EDWARD E. ANDERSON
SURV
ENG