

LAND CORNER RECORDATION CERTIFICATE
Filing Requirement of Act 74, Mich. P.A. 1970 as Amended

For corners in

| | | |
|------------------------------------|-----------------|---------------|
| Mackinac | Located In: | Corner Code # |
| (County) | | |
| 1. Public Land Survey | T R | |
| | T R | |
| | T R | |
| 2. Property Controlling in Section | S 13 T 42N R 1E | 15 |
| | S 13 T 42N R 1E | 11 |
| | S T R | |
| 3. Miscellaneous Property in Sec. | S T R | |
| | S T R | |
| 4. Lot No. , Recorded Plat | | |
| 5. Private Claims | | |

Register of Deeds Stamp & File Number

| | A | B | C | D | E | F | G | H | I | J | K | L | M |
|----|----|---|----|---|----|---|----|---|----|---|----|---|---|
| 1 | | | | | | | | | | | | | |
| 2 | 6 | | 5 | | 4 | | 3 | | 2 | | 1 | | |
| 3 | | | | | | | | | | | | | |
| 4 | 7 | | 8 | | 9 | | 10 | | 11 | | 12 | | |
| 5 | | | | | | | | | | | | | |
| 6 | 18 | | 17 | | 16 | | 15 | | 14 | | 13 | | |
| 7 | | | | | | | | | | | | | |
| 8 | 19 | | 20 | | 21 | | 22 | | 23 | | 24 | | |
| 9 | | | | | | | | | | | | | |
| 10 | 30 | | 29 | | 28 | | 27 | | 26 | | 25 | | |
| 11 | | | | | | | | | | | | | |
| 12 | 31 | | 32 | | 33 | | 34 | | 35 | | 36 | | |
| 13 | | | | | | | | | | | | | |

I, Stephan J. Szyszkoski, in a field survey on 15 02/09/2010 do hereby state that under requirements of P.A. 74, Michigan P.A. of 1970, the corner points mentioned in lines 1 and 2 above were in conformance with regulations and rules therefore as required in the current manual of survey instructions of the United States Department of the Interior, Bureau of Land Management or by a decree of a Court of Law and /or that the corner points mentioned in lines 3, 4 and 5 above were in conformance with the rules of the Michigan Board of Land Surveyors or by a Decree of a Court of Law; established, re-established, monumented, recovered, found as expressed below:

NOTE: Not more than 2 corners, all in the same town and range, may be recorded on this certificate.

A. Description of original monument and accessories and/or subsequent restoration:

(15-Sec. 13) West 1/16 corner between Sections 13 and 24. Not established in the original survey.

(11-Sec. 13) Southwest 1/16 corner, Section 13. Not established in the original survey.

B. Description of corner evidence found and/or method applied in restoring or reestablishing corner:

(15-Sec. 13) Established the corner midway and on the Section line between Section corner 1314.22' west and Quarter corner 1314.22' east.

(11-Sec. 13) Established the corner at the intersection of straight lines connecting opposite 1/16 corners.

C. Description of monument for corner and accessories established to perpetuate locating the position of the corner:


(15) Set 1"IDx36" I.pipe with 4" alum. MDNR cap made firm in a mound of rock. Set measuring nail with MDNR tag in the side of:
12" W.Spruce S65W 27.8' mrkd "W1/16 BT"
7" W.Birch S78E 3.4' do
7" W.Spruce S16E 29.7' do
6" W.Birch N60W 18.4' do
Bearings are magnetic.

(11) Set 1"IDx36" I.pipe with 4" alum. MDNR cap made firm in a mound of rock. Set measuring nail with MDNR tag in the side of:
10" Sugar S52W 11.15' mrkd "SW1/16 BT"
14" W.Birch N02E 27.6' do
5" Sugar (clump) N65E 15.9' do
10" W.Birch S17E 20.75' do
Bearings are magnetic.

Signed by Stephan J. Szyszkoski
Surveyor's Michigan License No. 33986

Date 05/20/2010

For the Michigan Department of Natural Resources and Environment, Forest Management Division

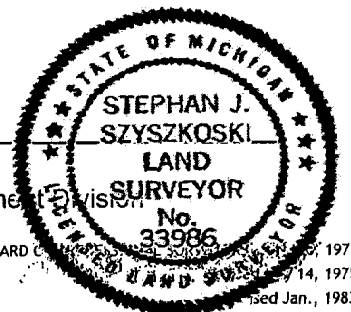

47361

47362