

SURVEY &
REMONUMENTATION

APR 28 1995

COMMISSION

MACKINAC COUNTY REMONUMENTATION

LAND CORNER RECORDATION CERTIFICATE

Filing Requirement of Act 74, Mich. P.A. 1970

For corners in

Mackinac

(County)

Located In:

Corner Code ~~##~~

1. Public Land Survey

T 42N R 5W

E-7

T R

T R

T R

2. Property Controlling
in Section

S T R

S T R

3. Miscellaneous

S T R

Property in Sec.

S T R

Register of Deeds Stamp & File Number

4. Lot No. , Recorded Plat

5. Private Claims

I, James H. Granger, in a field survey on August 9, 19 94,

do hereby certify that under requirements of P.A. 74, Michigan P.A. of 1970, the corner points mentioned in lines 1 and 2 above were in conformance with regulations and rules therefore as required in the current manual of survey instructions of the United States Department of the Interior, Bureau of Land Management or by a decree of a Court of Law and/or that the corner points mentioned in lines 3, 4 and 5 above were in conformance with the rules of the Michigan Board of Land Surveyors or by a Decree of a Court of Law; established, re-established, monumented, re-monumented, recovered, found as expressed below:

NOTE: Not more than 4 corners, all in the same town and range, may be recorded on this certificate.

A. Description of original monument and accessories and/or subsequent restoration:

1845 Original Survey Set Wood post, 10" Cedar S21°E 44 lks, 18" Hemlock S29°W 41 lks
H. Brevoort
1915 D.A. Brotherton No evidence fd.
1984 Michael Lange
#30089 Set 2½" pipe w/brass cap

B. Description of corner evidence found and/or method applied in restoring or reestablishing corner:

Fd USFS Monument and 4 witnesses. Placed 5/8" rebar w/aluminum cap in Monument Box.


ACCEPTED BY THE MACKINAC COUNTY
SURVEY PEER GROUP AS THE
OFFICIAL CORNER UNDER P.A.
345 OF 1990 AT A MEETING
HELD ON 10-17-94

James H. Granger

C. Description of monument for corner and accessories established to perpetuate locating the position of the corner:

USFS Monument

W. Birch 13" N35°E 88.7'
W. Birch 10" N28°W 85.5'
Cedar 6" S25°W 33.3'
Post S00°E 12.0'

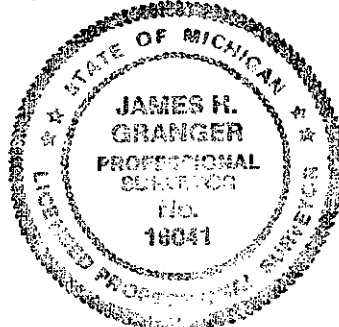

Signed by *James H. Granger*

Date 11-16-94

Surveyor's Michigan License No. 16041

12-01-94 FORM APPROVED BY MICHIGAN STATE BOARD OF LAND SURVEYORS, JAN. 28, 1971

REVISED MAY 14, 1975
REVISED JAN., 1983

D - 0341