

MACKINAC COUNTY REMONUMENTATION

LAND CORNER RECORDATION CERTIFICATE Filing Requirement of Act 74, Mich. P.A. 1970

For corners in
Mackinac

(County)

Located In:

Corner Code ##

1. Public Land Survey

T 42N R 6W

G-7

T R

T R

T R

T R

2. Property Controlling
in Section

S T R

S T R

3. Miscellaneous
Property in Sec.

S T R

S T R

4. Lot No. , Recorded Plat

5. Private Claims

RECEIVED & FILED
DIANE FRANKOVICH
MACKINAC COUNTY REGISTRE OF DEEDS

NOV - 7 1995

AM

PM

7|8|9|10|11|12|1|2|3|4|5|6

A

Register of Deeds Stamp & File Number

I, James H. Granger, in a field survey on October 4, 1995,

do hereby certify that under requirements of P.A. 74, Michigan P.A. of 1970, the corner points mentioned in lines 1 and 2 above were in conformance with regulations and rules therefore as required in the current manual of survey instructions of the United States Department of the Interior, Bureau of Land Management or by a decree of a Court of Law and/or that the corner points mentioned in lines 3, 4 and 5 above were in conformance with the rules of the Michigan Board of Land Surveyors or by a Decree of a Court of Law; established, re-established, monumented, re-monumented, recovered, found as expressed below:

NOTE: Not more than 4 corners, all in the same town and range, may be recorded on this certificate.

A. Description of original monument and accessories and/or subsequent restoration:

1845 Original Survey set wood post 16"beech N72°W 30 lks. 16"beech S65°W 10 lks.
H. Brevoort

1915 D. Brotherton 30# rail

1962 DNR-Billy Buckler #8887 1"pipe w/ 1/2" rod inside

1974 Lawrence Feindt #21566 fd. 1 1/4"pipe w/ 1/4"rod inside, raised w/ 5/8"pipe

B. Description of corner evidence found and/or method applied in restoring or reestablishing corner:

Worth Road reconstructed. Ex. 5/8"pipe and witnesses measured by Northwoods Inc. prior to construction. Fd. 2 original witnesses by Feindt and 1 original witness by DNR. Fd. pipe inside monument box with concrete in bottom of box. Could not remove. Inserted 1/2" rebar inside pipe.

**SURVEY &
REMONUMENTATION**

DEC 01 1995

COMMISSION


ACCEPTED BY THE MACKINAC COUNTY
SURVEY PEER GROUP AS THE
OFFICIAL CORNER UNDER P.A.
345 OF 1990 AT A MEETING
HELD ON 9-18-95

James H. Granger

C. Description of monument for corner and accessories established to perpetuate locating the position of the corner:

5/8"pipe with 1/2"rebar and remonumentation cap inside monument box.

| | | | |
|-----------------|-------|--------|--------|
| 8"maple | N34°E | 52.41' | fd tag |
| powerpole | S53°E | 53.16' | fd tag |
| 4"maple | S47°W | 70.03' | fd tag |
| USGS conc. mon. | N27°W | 34.77' | |

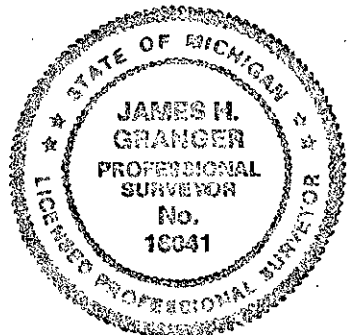

Signed by *James H. Granger*

Date 10/27/95

Surveyor's Michigan License No. 16041

D-0364