

## MACKINAC COUNTY REMONUMENTATION

LAND CORNER RECORDATION CERTIFICATE  
Filing Requirement of Act 74, Mich. P.A. 1970RECEIVED & FILED  
DIANE FRANKOVICH  
MACKINAC COUNTY REGISTER OF DEEDS

NOV - 7 1995

AM 7 8 9 10 11 12 1 2 3 4 5 6 PM

Register of Deeds Stamp &amp; File Number

For corners in

Mackinac  
(County)

Located In:

Corner Code ##

1. Public Land Survey	T 42N R 6W	I-7
	T R	
	T R	
	T R	
	T R	
2. Property Controlling in Section	S T R	
	S T R	
3. Miscellaneous Property in Sec.	S T R	
	S T R	

4. Lot No. , Recorded Plat  
5. Private Claims

I, James H. Granger, in a field survey on October 4, 19 95, do hereby certify that under requirements of P.A. 74, Michigan P.A. of 1970, the corner points mentioned in lines 1 and 2 above were in conformance with regulations and rules therefore as required in the current manual of survey instructions of the United States Department of the Interior, Bureau of Land Management or by a decree of a Court of Law and/or that the corner points mentioned in lines 3, 4 and 5 above were in conformance with the rules of the Michigan Board of Land Surveyors or by a Decree of a Court of Law; established, re-established, monumented, re-monumented, recovered, found as expressed below:

**NOTE: Not more than 4 corners, all in the same town and range, may be recorded on this certificate.**

## A. Description of original monument and accessories and/or subsequent restoration:

1845 Original Survey set wood post 14"beech N49°W 6 lks. 12"birch N35°E 37 lks.  
H. Brevoort.

1915 D. Brotherton 1"rod  
1974 Lawrence Feindt #8887 1"railroad spike  
1978 Max Connell #17616 replaced railroad spike w/ 5/8" copper rod

## B. Description of corner evidence found and/or method applied in restoring or reestablishing corner:

Worth Road reconstructed. Ex. 5/8" copper rod and witnesses measured by Northwoods Inc. prior to construction. Fd. 5/8" copper rod inside monument box with concrete in bottom of box.

SURVEY &  
REMONUMENTATION

DEC 01 1995

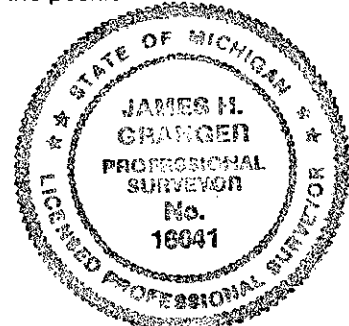
COMMISSION

ACCEPTED BY THE MACKINAC COUNTY  
SURVEY PEER GROUP AS THE  
OFFICIAL CORNER UNDER P.A.  
345 OF 1990 AT A MEETING  
HELD ON 9-10-95*James H. Granger*

## C. Description of monument for corner and accessories established to perpetuate locating the position of the corner:

5/8" copperrod with remonumentation cap inside monument box.

tw. 6"birch	N31°E	64.72'	fd tag
6"maple	S31°E	68.62'	fd tag
8"beech	S52°W	89.90'	fd tag
powerpole	S73°W	101.72'	fd tag
1/2"iron	N46°W	56.57'	

Signed by *James H. Granger* Date 10/27/95  
Surveyor's Michigan License No. 16041

D-0366

FORM APPROVED BY MICHIGAN STATE BOARD OF LAND SURVEYORS, JAN. 28, 1971  
REVISED MAY 14, 1975  
REVISED JAN., 1983