

MICHIGAN
DEPARTMENT OF CONSERVATION
FORESTRY DIVISION

LAND CORNER RECORD

T. 42 N.R. 12 W


Mackinac COUNTY

DESCRIPTION OF CORNER Section Corner common to Secs. 27-28-33-34

CORNER MONUMENT 1" Pipe with 4" Aluminum Cap

DATE MONUMENT PLACED AND WITNESSED 9/25/64 with J. Halbach, District Forester

WITNESSES TO CORNER..... 9" Beech (S34 NBT), South, 13.5°

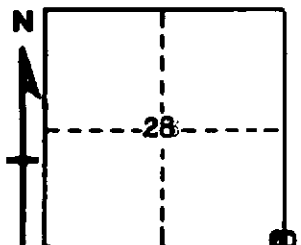

CIRCLE CORNER REGISTERED

6" Soft Maple (S33 NBT), S 70° W, 18.5°

14 Feet

10" Hard Maple (S28 NBT), North, 44.2°

AND

DESCRIPTION IN DETAIL AS TO HOW CORNER WAS LOCATED AND IDENTIFIED OR RESTORED.

This Corner was replaced from one possible B.T., a Birch bearing S 64° W, 42 Dec.
Stump in poor condition. Squared and Scribed 4" Hard Maple at corner.

SURVEYOR'S SEAL

SIGNED Billy D. Buckler DATE 10/20/1964
REGISTERED LAND SURVEYOR