

1994 Mackinac County Remonumentation Corner.

SURVEY &
REMONUMENTATION
Commissioners in
Mackinac
APR 10 1995
COMMISSION

LAND CORNER RECORDATION CERTIFICATE
Filing Requirement of Act 74, Mich. P.A. 1970

Located In: _____ Corner Code ## _____

1. Public Land Survey T 42N R 4W _____ D-11
T _____ R _____
T _____ R _____
T _____ R _____

2. Property Controlling S _____ T _____ R _____
in Section S _____ T _____ R _____

3. Miscellaneous S _____ T _____ R _____
Property in Sec. S _____ T _____ R _____

4. Lot No. _____, Recorded Plat _____

5. Private Claims _____

RECEIVED & FILED
MACKINAC COUNTY
NOV 09 1994

Register of Deeds Stamp & File Number

	A	B	C	D	E	F	G	H	I	J	K	L	M
2	6		5		4		3		2		1		
3													
4	7		8		9		10		11		12		
5													
6	18		17		16		15		14		13		
7													
8	19		20		21		22		23		24		
9													
10	30		29		28		27		26		25		
11													
12	31		32		33		34		35		36		
13													

David B. Guthrie, in a field survey on June 15, 1994,
do hereby certify that under requirements of P.A. 74, Michigan P.A. of 1970, the corner points mentioned
in lines 1 and 2 above were in conformance with regulations and rules therefore as required in the
current manual of survey instructions of the United States Department of the Interior, Bureau of Land
Management or by a decree of a Court of Law and/or that the corner points mentioned in lines 3, 4 and 5
above were in conformance with the rules of the Michigan Board of Land Surveyors or by a Decree of a
Court of Law, established, re-established, monumented, re-monumented, recovered, found as
expressed below:

NOTE: Not more than 4 corners, all in the same town and range, may be recorded
on this certificate.

A. Description of original monument and accessories and/or subsequent restoration:
1845: Established by James A. Mullett, G.L.O. Survey. Set post and referenced:
Sugar 16/S79W/13 Fir 10/N79E/15
±1960: Survey by MDSH. Found Boat Spike.
1964: Survey by T.L. Jackson. Found Corner.
1973: Survey by Mary Feindt. Found Corner.
1980: Survey by Orlando Doyle. Found T-Iron.
1983: Survey by Beryl M. Jones. Found T-Iron.


B. Description of corner evidence found and/or method applied in restoring or reestablishing corner:
1994: Found 1" T-Iron 1.5 feet North of the Centerline of Charles Moran
Road and the Centerline of East Lake Road North.

ACCEPTED BY THE MACKINAC COUNTY
SURVEY PEER GROUP AS THE
OFFICIAL CORNER UNDER P.A.
345 OF 1990 AT A MEETING
HELD ON 8-16-94

James H. Granger

C. Description of monument for corner and accessories established to perpetuate locating the position of the corner:
1994: Set Mackinac County Remonumentation Corner.
A 5/8" by 24" Iron Rod with a 3" aluminum cap stamped to identify the
corner set within a monument box.

Referenced:
S28°E - 55.75 feet - Utility Pole
N78°E - 75.40 feet - Utility Pole (Exist.)
N16°W - 101.74 feet - 10" Spruce (Exist.)
S46°W - 75.20 feet - 12" White Pine (Exist.)

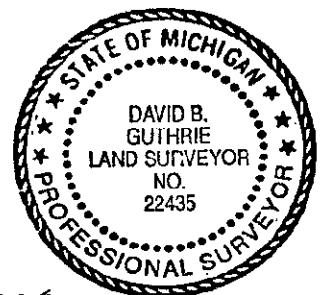

Signed by David B. Guthrie Date Oct. 21, 1994
Surveyor's Michigan License No. 22435

11-09-94 FORM APPROVED BY MICHIGAN STATE BOARD OF LAND SURVEYORS, JAN. 28, 1971
REVISED MAY 14, 1975
REVISED JAN., 1983

D-0322