

LAND CORNER RECORDATION CERTIFICATE
Filing Requirement of Act 74, Mich. P.A. 1970

For corners in

Mackinac

(County)

Located In:

Corner Code #

1. Public Land Survey

T44N R 9W L12
T R
T R
T R

2. Property Controlling
in Section

S36 T44N R 9W 12
S T R

3. Miscellaneous
Property in Sec.

S T R
S T R

Register of Deeds Stamp & File Number

4. Lot No. , Recorded Plat

5. Private Claims

Jan 29 2007

I, Stephan J. Szyszkoski, in a field survey on _____, 19__ do hereby state that under requirements of P.A. 74, Michigan P.A. of 1970, the corner points mentioned in lines 1 and 2 above were in conformance with regulations and rules therefore as required in the current manual of survey instructions of the United States Department of the Interior, Bureau of Land Management or by a decree of a Court of Law and/or that the corner points mentioned in lines 3, 4 and 5 above were in conformance with the rules of the Michigan Board of Land Surveyors or by a Decree of a Court of Law, established, re-established, monumented, recovered, found as expressed below:

NOTE: Not more than 2 corners, all in the same town and range, may be recorded on this certificate.

	A	B	C	D	E	F	G	H	I	J	K	L	M
1													
2		6		5		4		3		2		1	
3													
4		7		8		9		10		11		12	
5													
6		18		17		16		15		14		13	
7													
8		19		20		21		22		23		24	
9													
10		30		29		28		27		26		25	
11													
12		31		32		33		34		35		36	
13													

A. Description of original monument and accessories and/or subsequent restoration:

(L12) Center of Section 36. Not established in the original survey.
(12-Sec. 36) South 1/16 corner, Section 36. Not established in the original survey.


B. Description of corner evidence found and/or method applied in restoring or reestablishing corner:

(L12) Established the corner at the intersection of straight lines connecting opposite 1/4 corners. The position for the corner falls in the northerly end of an open marsh.
(12-Sec. 36) Established the corner midway and on a straight line between Quarter corner L13 1327.25' south and Center of Section 36 1327.25' north.

C. Description of monument for corner and accessories established to perpetuate locating the position of the corner:

(L12) Set 1"IDx36" I.pipe with 4" alum.
MDNR cap. Set measuring nails in:
10" R.Pine N71E 89.95' mrkd "CS BT"
6" Spruce S64E 74.5' do
7" Tamarack S54W 80.35' do
4" W.Pine N07W 54.6' do
Bearings are magnetic. Distances are to
nail with tag.

(12) Set 1"IDx36" I.pipe with 4" alum.
MDNR cap. Set measuring nails in:
6" Balsam S25W 7.91' mrkd "S1/16 BT"
9" Spruce N42W 7.55' do
15" W.Birch N27E 26.32' do
10" Spruce S51E 16.04' do
Bearings are magnetic. Distances are to
nail with tag.

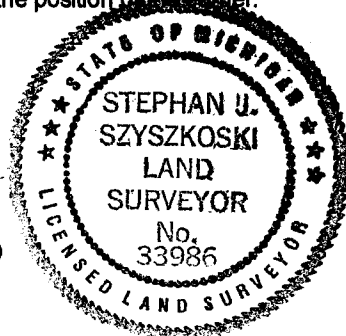

Signed by

Stephan J. Szyszkoski

Surveyor's Michigan License No.

33986

Date

5/16/07

For the Michigan Department of Natural Resources