

MACKINAC COUNTY REMONUMENTATION CORNER

MAY 20 1997

LAND CORNER RECORDATION CERTIFICATE
Filing Requirement of Act 74, Mich. P.A. 1970

For corners in
MACKINAC

Located In:

Corner Code #

(County)

1. Public Land Survey

T 44N R 12W

T R

T R

T R

2. Property Controlling
in Section

S T R

S T R

3. Miscellaneous
Property in Sec.

S T R

S T R

3

RECEIVED & FILED
DIANE FRANKOVICH
MACKINAC COUNTY REGISTER OF DEEDS

NOV 15 1996

AM PM
7|8|9|10|11|12|1|2|3|4|5|6

Register of Deeds Stamp & File Number

4. Lot No. , Recorded Plat

5. Private Claims

I, JAMES H. GRANGER, in a field survey on October 2, 19 96
do hereby state that under requirements of P.A. 74, Michigan P.A. of 1970, the corner points
mentioned in lines 1 and 2 above were in conformance with regulations and rules therefore as
required in the current manual of survey instructions of the United States Department of the Interior,
Bureau of Land Management or by a decree of a Court of Law and /or that the corner points
mentioned in lines 3, 4 and 5 above were in conformance with the rules of the Michigan Board of
Land Surveyors or by a Decree of a Court of Law; established, re-established, monumented,
recovered, found as expressed below:

NOTE: Not more than 2 corners, all in the same town and range, may be recorded
on this certificate.

	A	B	C	D	E	F	G	H	I	J	K	L	M
1													
2	6			5			4		3		2		1
3													
4	7			8			9		10		11		12
5													
6	18			17			16		15		14		13
7													
8	19			20			21		22		23		24
9													
10	30			29			28		27		26		25
11													
12	31			32			33		34		35		36
13													

A. Description of original monument and accessories and/or subsequent restoration:

1841 - Original Survey Set wood post 8" Cottonwood N59°E 67 lks
W. Burt

1975 - Survey 3/8" iron
Thomas O'Brien # 21274

1975 - Survey 3/8" iron
Thomas O'Brien # 21274

ACCEPTED BY THE MACKINAC COUNTY
SURVEY PEER GROUP AS THE
OFFICIAL CORNER UNDER P.A.
345 OF 1990 AT A MEETING
HELD ON 9-30-96

James H. Granger

B. Description of corner evidence found and/or method applied in restoring or reestablishing corner:


Found 3/8" iron in water on line between the E 1/4 Section 13 and the SE corner Section 24. Placed corner on line away from water.

C. Description of monument for corner and accessories established to perpetuate locating the position of the corner

Also M.C. corner, T44N, R11W

Set 5/8" X 30" rebar with Remonumentation Cap

Concrete Monument	S58°W	3.76'	Set tag
6" Cedar	S03°W	3.94'	Set tag
10" Maple	S70°E	17.60'	Set tag
10" Balsam	N80°E	10.80'	Set tag

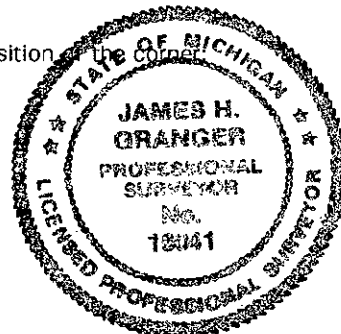

Signed by *James H. Granger*

Date 10-10-96

Surveyor's Michigan License No. 16041