

LAND CORNER RECORDATION CERTIFICATE  
Filing Requirement of Act 74, Mich. P.A. 1970

or corners in

MACOMB (County)	Located in:	City of Sterling Heights	Corner Code #
Public Land Survey	T 2N	R 12E	I-9
	T	R	
	T	R	
	T	R	
Property Controlling in Section	S	T	R
Miscellaneous	S	T	R
Property in Sec.	S	T	R

SURVEY &  
REMONUMENTATION  
  
FEB 27 1997  
  
COMMISSION

Register of Deeds Stamp & File Number


Lot No. \_\_\_\_\_, Recorded Plat \_\_\_\_\_  
Private Claims \_\_\_\_\_

Randy Kolehouse, in a field survey on May 28 19 96,  
hereby certify that under requirements of P.A. 74 Michigan P.A. of 1970, the corner points mentioned  
lines 1 and 2 above were in conformance with regulations and rules therefore as required in the  
current manual of survey instructions of the United States Department of the Interior, Bureau of Land  
Management or by a decree of a Court of Law and/or that the corner points mentioned in lines 3, 4 and 5  
above were in conformance with the rules of the Michigan Board of Land Surveyors or by a Decree of a  
Court of Law; established, re-established, monumented, re-monumented, recovered, found as  
expressed below:

NOTE: Not more than 4 corners, all in the same town and range, may be recorded  
on this certificate.

Description of original monument and accessories and/or subsequent restoration:

1817	G.L.O. Notes	Wampler	N/A	Set Post
N/A	MCRC File No. 109	N/A	N/A	Iron 3" Down
1967	MCRC File No. 109	N/A	N/A	Iron Rod
1969	MCRC File No. 109	N/A	N/A	Iron in Monument Box

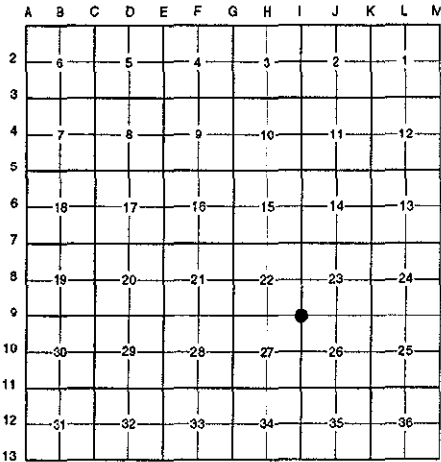

Description of corner evidence found and/or method applied in restoring or reestablishing corner:

I found a 3/8" iron rod in a monument box at the C/L of Dodge Park Road (asph.) running North and South and the C/L of  
16 Mile Road (conc.) running East and West which checks with witnesses listed below. No witnesses remain from  
Wampler's G.L.O. notes or from the Macomb County Road Commission non-dated and 1967 records.

1969 Macomb County Road Commission Records  
SE 101.20' P.K. Nail and Washer in D.E. Pole (m. 101.27')  
NW 117.63' Iron (m. 118.09' to Bent Iron)

Measure North 2600.18' to I-8 (G.L.O. = 2640.0')  
Measure East 2646.66' to J-9 (G.L.O. = 2669.04')  
Measure West 2566.16' to H-9 (G.L.O. = 2583.9')

ACCEPTED BY THE MACOMB COUNTY SURVEY PEER  
GROUP AS THE OFFICIAL CORNER UNDER MICHIGAN  
PUBLIC ACT 345 OF 1890 AT A MEETING HELD  
ON 9-17-96

William E. Soderberg  
WILLIAM E. SODERBERG, P.S., CHAIRMAN

Description of monument for corner and accessories established to perpetuate locating the position of the corner:

I replaced the 3/8" iron rod with a 3/4" x 24" iron rod w/2" diameter aluminum cap stamped "Macomb County Monument MI  
Act 345 #25854" in an existing monument box.

N 09° E 125.28' - Set Nail and Macomb Co. Remon. Tag in SE Face Lt. Pole  
S 84° E 39.19' - Set Nail and Macomb Co. Remon. Tag in S Face P. Pole  
S 16° W 110.97' - Set "+" in NE Bolt Signal Pole Base  
N 45° W 108.41' - Set Nail and Macomb Co. Remon. Tag in NE Face Lt. Pole

The selected location is accepted by me and is generally accepted by professional surveyors  
as the best available evidence of the position of the original corner.

Surveyed by Randy J. Kolehouse Date 11/19/96  
Surveyor's Michigan License No. 25854

