

LAND CORNER RECORDATION CERTIFICATE
Filing Requirement of Act 74, Mich. P.A. 1970

For corners in

Macomb
(County)

Located In:
Shelby Twp.

Corner Code #

1. Public Land Survey

T R
T R
T R
T R

#4

2. Property Controlling
in Section

S 20 T 3N. R 12E.
S 21 T 3N. R 12E.

Centerline int. @

3. Miscellaneous
Property in Sec.

S T R
S T R

Mound Rd. &
Shelby Rd.

SURVEY &
REMONUMENTATION

MAR 15 1999

SECTION

Register of Deeds Stamp & File Number

4. Lot No. _____ Recorded Plat _____

5. Private Claims _____

ACCEPTED BY THE MACOMB COUNTY SURVEY PEER
GROUP AS THE OFFICIAL CORNER UNDER MICHIGAN
PUBLIC ACT 345 OF 1990 AT A MEETING HELD
ON 10/13/98

WILLIAM E. SODERBERG, P.S., CHAIRMAN

I, Jeffrey A. Wright, in a field survey on 24 August, 19 98 do hereby state that under requirements of P.A. 74, Michigan P.A. of 1970, the corner points mentioned in lines 1 and 2 above were in conformance with regulations and rules therefore as required in the current manual of survey instructions of the United States Department of the Interior, Bureau of Land Management or by a decree of a Court of Law and/or that the corner points mentioned in lines 3, 4 and 5 above were in conformance with the rules of the Michigan Board of Land Surveyors or by a Decree of a Court of Law; established, re-established, monumented, recovered, found as expressed below:

NOTE: Not more than 2 corners, all in the same town and range, may be recorded on this certificate.

	A	B	C	D	E	F	G	H	I	J	K	L	M
1													
2	6		5		4		3		2		1		
3													
4	7		8		9		10		11		12		
5													
6	18		17		16		15		14		13		
7													
8	19		20		21		22		23		24		
9													
10	30		29		28		27		26		25		
11													
12	31		32		33		34		35		36		
13													

A. Description of original monument and accessories and/or subsequent restoration:

Date	Surveyor	Number	Type	L.	P.	Monument Box
No Original Monument Set						
1977	Avey	15396	S. PK Nail Act 132	Unrecorded		No

B. Description of corner evidence found and/or method applied in restoring or reestablishing corner:

Found PK nail (0.20' S. & 0.58' E.) & MAG nail (0.37' S. & 1.28' W.), they do not fit previous location or any adjacent surveys and/or plats.


Location supported by corners in:
Ford Motor Company monumentation
Tietenberg Sub. L. 41, P. 22
Forcier's Valley View Sub. L. 32, P. 31
S/P of Forcier's Shelby-Mound Sub. L. 33, P. 47

Ground Distances:
to E-8 = 1429.59' m.
to E-9 = 1204.10' m. (1204.10' Avey 1977)
to Centerline intersection @ 22 Mile Rd. & Shelby Rd.
= 1439.86' m. (1440.59' Avey 1977)

C. Description of monument for corner and accessories established to perpetuate locating the position of the corner:

Set 3/4" bar with an aluminum cap stamped "Macomb County Monument - Mi Act 345 #40165" in a new monument box. (Corner is on Section Line)

87.47' (AZ. 345°) to MAG nail w/ Macomb County Witness Tag in W side 14" pine
35.22' (AZ. 285°) to MAG nail w/ Macomb County Witness Tag in N side U. pole
46.89' (AZ. 177°) to steel encased concrete monument
59.32' (AZ. 95°) to MAG nail w/ Macomb County Witness Tag in SE side U. pole
145.80' (AZ. 153°) to MAG nail w/ Macomb County Witness Tag in E side 30" oak

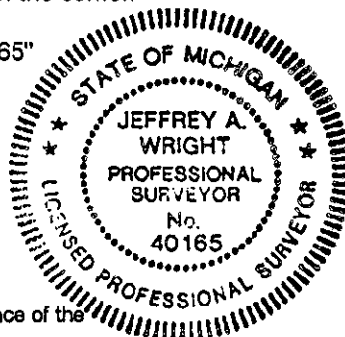

The selected location is accepted by me and is generally accepted by Professional Surveyors as the best available evidence of the position of the original corner.

Signed by

Jeffrey A. Wright

Date:

12 NOVEMBER 1998

Surveyor's Michigan License No. 40165