

LIBER 06166P003

B999616

## LAND CORNER RECORDATION CERTIFICATE

Filing Requirement of Act 74, Mich. P.A. 1970

RECORDED IN MACOMB COUNTY  
RECORDS AT: 8:30 A M.

For corners in

Macomb  
(County)

Located in:

Corner Code #

Chesterfield

DEC 28 1993

1. Public Land Survey

T 3 N. R 14 E

K-1

T R

T R

T R

2. Property Controlling  
in Section

S T R

S T R

3. Miscellaneous

S T R

Property in Sec.

S T R

Clerk - Recorder of Deeds  
MACOMB COUNTY, MICHIGAN

Register of Deeds Stamp &amp; File Number

4. Lot No. , Recorded Plat

5. Private Claims

	A	B	C	D	E	F	G	H	I	J	K	L	M
2	6		5		4		3		2		1		
3													
4	7		8		9		10		11		12		
5													
6	18		17		16		15		14		13		
7													
8	19		20		21		22		23		24		
9													
10	30		29		28		27		26		25		
11													
12	31		32		33		34		35		36		
13													

I, Steven E. Dunn, in a field survey on December 8, 1993, do hereby certify that under requirements of P.A. 74, Michigan P.A. of 1970, the corner points mentioned in lines 1 and 2 above were in conformance with regulations and rules therefore as required in the current manual of survey instructions of the United States Department of the Interior, Bureau of Land Management or by a decree of a Court of Law and/or that the corner points mentioned in lines 3, 4 and 5 above were in conformance with the rules of the Michigan Board of Land Surveyors or by a Decree of a Court of Law; established, re-established, monumented, re-monumented, recovered, found as expressed below:

**NOTE: Not more than 4 corners, all in the same town and range, may be recorded on this certificate.**

A. Description of original monument and accessories and/or subsequent restoration:

GLO Post - No. Evidence of Original Corner.

GLO Original survey performed by Preston 2-18-1818.

L.C.R.C.: L.2380, P.496 Robert J. Patterson #17631 March 27, 1973

K-1 - 1/2" Rod in Hand Hole. - Witness - P.K. Nail in 18" Tree, NW'ly - 75.05'


P.K. Nail in Utility Pole N.E.'ly - 97.44 (Found)

P.K. Nail in Utility Pole S.E.'ly - 74.71'

Note: Monument Box for South 1/4 Cor. Sec. 35, T.4.N., R.14E., is 418.73' West of K-1

B. Description of corner evidence found and/or method applied in restoring or reestablishing corner:

K-1 Found 1/2" Iron Rod in Monument Box under 4" Asphalt. Corner matches that one described above and agreed with found Witness. This corner is 0.97' South of line between South 1/4 corner and SE corner of Section 35, Town 4 North, Range 14 East (Lenox Township). Lenox Township was subdivided first so corner should fall on above line.

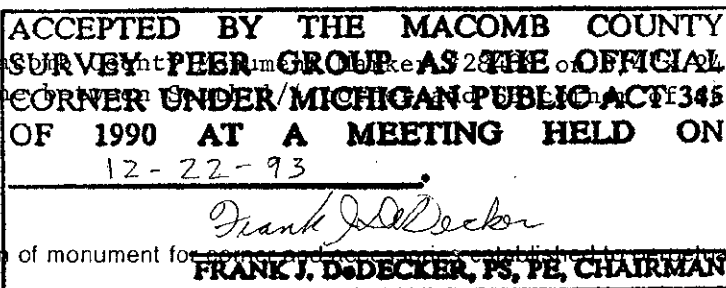

C. Description of monument for corner and accessories established to locate the position of the corner AND  
Set Macomb County Monument Marker #28408 on 3/4" x 24" Iron Rod in Monument Box on line between Section 35, T.4.N., R.14E., (Lenox Township)

K-1 T.3N., R.14E.

Macomb County Monument Marker #28408 on 3/4" x 24" Iron Rod in Monument Box

Witnesses:

N.75°E. - 97.19' Set P.K. and Macomb County Witness tag @ NW face U.P.

N.07°W. - 65.69' Set P.K. and Macomb County Witness tag @ West face 29" Hickory

S.52°E. - 52.14' Set P.K. and Macomb County Witness tag @ NE face 12" Elm

N.64°E. - 50.08' Set P.K. and Macomb County Witness tag in centerline of Asphalt drive and centerline of CMP Culvert.

South - 0.97' Found 1/2" Iron Rod in Monument Box under 4" Asphalt.

The selected location is a careful and faithful perpetuation of the position of the original corner.

Signed by Steven E. Dunn

Date 12-22-1993

Surveyor's Michigan License No. 28408