

LAND CORNER RECORDATION CERTIFICATE

Filing Requirement of Act 74, Mich. P.A. 1970

For corners in

Manistee
(County)

Located in:

Corner Code #

1. Public Land Survey T 21N R 16W K-13
T R
T R
T R
2. Property Controlling S T R
in Section S T R
3. Miscellaneous S T R
Property in Sec. S T R

4. Lot No. , Recorded Plat
5. Private Claims

I, Richard L. Hays, in a field survey on April 1997, do hereby certify that under requirements of P.A. 74, Michigan P.A. of 1970, the corner points mentioned in lines 1 and 2 above were in conformance with regulations and rules therefore as required in the current manual of survey instructions of the United States Department of the Interior, Bureau of Land Management or by a decree of a Court of Law and/or that the corner points mentioned in lines 3, 4 and 5 above were in conformance with the rules of the Michigan Board of Land Surveyors or by a Decree of a Court of Law; established, re-established, monumented, re-monumented, recovered, found as expressed below:

NOTE: Not more than 4 corners, all in the same town and range, may be recorded on this certificate.

A. Description of original monument and accessories and/or subsequent restoration:

K-13 SOUTHEAST CORNER OF SECTION 35, T21N-R16W
1838: G.I.O Post
11" Yellow Pine N-75°-E 85 lks (1)
11" Yellow Pine N-70°-W 15 lks (2)

1972: Robert Griffin #13584, LCRC #73-29
Set Corner at Proportionate Distance between Controlling Corners.
8" Black Oak N-42°-E 55.97' (3)
5" Black Oak N-70°-E 61.50' (4)
10" White Oak N-30°-W 57.86' (5)
4" Pine Post North 2.0' (6)

1972: Ross Surveys #17634 - Act 132
No Witnesses:
Distance checked between the Southwest to the South Quarter Corner = 2654.56'

B. Description of corner evidence found and/or method applied in restoring or reestablishing corner:

K-13 SOUTHEAST CORNER OF SECTION 35, T21N-R16W

April 1997: Found a 5" Square Concrete Monument, 5' in length with a 3" Stamped Brass Disc, 1.5' above the ground.

Condition of the Witnesses are as follows:

11" Yellow Pine	N-75°-E	85 lks (1)	GONE
11" Yellow Pine	N-70°-W	15 lks (2)	GONE
8" Black Oak	N-42°-E	55.97' (3)	FOUND
5" Black Oak	N-70°-E	61.50' (4)	GONE
10" White Oak	N-30°-W	57.86' (5)	FOUND
4" Pine Post	North	2.0' (6)	GONE

SURVEY &
REMONUMENTATION

OCT 14 1997

COMMISSION

Corner K-13 ratified by the Manistee County Peer Group according to the county plan adopted pursuant to P.A. 345 of 1990, as amended, (being the State Survey and Remonument Act, MCL 54.261 et. seq.). Date of Peer Review: JUN 3 1997


C. Description of monument for corner and accessories established to perpetuate locating the position of the corner:

K-13 SOUTHEAST CORNER OF SECTION 35, T21N-R16W

April 1997: Accepted the 5" Square Concrete Monument, 5' in length with a 3" Stamped Brass Disc, as a careful and faithful re-establishment of the position of the Original Corner.

12" Black Oak	N-42°-E	55.92' (3)
10" White Oak	N-30°-W	57.86' (5)
12" Black Oak	S-62°-E	58.40'
8" Jack Pine	S-15°-W	69.29'

Corner is 234' South of the Centerline of the County Line Road.

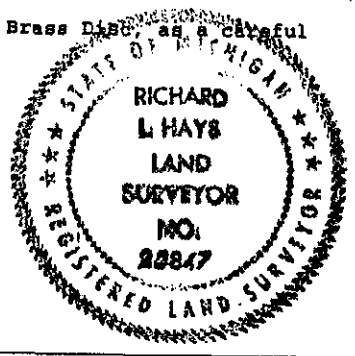

Signed by Richard Hays

Date 5/29/97

Surveyor's Michigan License No. 25847