

LAND CORNER RECORDATION CERTIFICATE
Filing Requirement of Act 74, Mich. P.A. 1970

1993

COMMISSION

For corners in

Manistee _____
(County)

Located In:

Corner Code //

REGISTER'S OFFICE
MANISTEE COUNTY


#93-287 AT 10 32 A.M.

MAY 12 1993

Ernest A. Papia
REGISTER OF DEEDS

Register of Deeds Stamp & File Number

1. Public Land Survey T _____ R _____
T _____ R _____
T _____ R _____
T _____ R _____
2. Property Controlling S 17 T 21N R 13W
in Section S _____ T _____ R _____
3. Miscellaneous S _____ T _____ R _____
Property in Sec. S _____ T _____ R _____

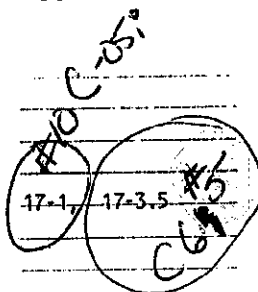

4. Lot No. _____, Recorded Plat _____
5. Private Claims _____

I, Norman C. Caldwell, in a field survey on September, 19 92, do hereby certify that under requirements of P.A. 74, Michigan P.A. of 1970, the corner points mentioned in lines 1 and 2 above were in conformance with regulations and rules therefore as required in the current manual of survey instructions of the United States Department of the Interior, Bureau of Land Management or by a decree of a Court of Law and/or that the corner points mentioned in lines 3, 4 and 5 above were in conformance with the rules of the Michigan Board of Land Surveyors or by a Decree of a Court of Law; established, re-established, monumented, re-monumented, recovered, found as expressed below:


NOTE: Not more than 4 corners, all in the same town and range, may be recorded on this certificate.

A. Description of original monument and accessories and/or subsequent restoration.

- 17-1 This position not established by original government survey.
17-3.5 Post Placed by J. Brink, 1838
S35°W 26 lks. (17.2') 6" Maple
S53°E 34 lks. (22.4') 8" Oak

B. Description of corner evidence found and/or method applied in restoring or reestablishing corner:

- 17-1 W 1/16 cor. Sec. 8 & 17, T21N-R13W
No subsequent record
17-3.5 I.R. @ Inter. Gov't Lots 4 & 5, Sec. 17 and Gov't Lots 1 & 9, Sec. 18, T21N-R13W
County Surveyor's record S.H. Baker, April 1907
Monument - gas pipe
N78°W 26.7' 24" W. Pine Stump
S28°W 47.3' 24" W. Pine Stump
County Surveyor minutes (also in field notes) by Theodore Norlin, June 9, 1922
Set iron pipe
N79°W 27.5' 30" Pine Stump
S30°W 47.7' 24" Pine Stump

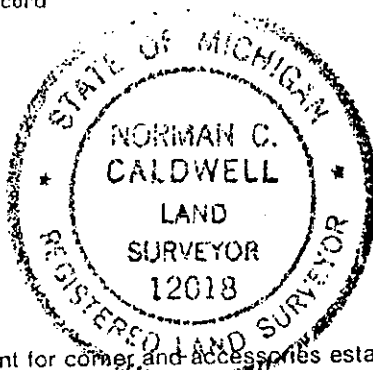

C. Description of monument for corner and accessories established to perpetuate locating the position of the corner:

- 17-1 W 1/16 cor., Sec. 8 & 17, T21N-R13W
Placed 5/8" iron bar w/alum. cap. This position not established by original government survey. This monument is accepted as a careful and faithful determination of the position of the cor.
N68°W 148.25' 12" W. Oak
N38°E 78.39' 8" W. Oak
S43°E 72.81' 12" W. Oak
S24°W 59.87' 8" B. Oak
South 25.00' Carsonite Witness Post
17-3.5 I.R. @ Inter. Gov't Lots 4 & 5, Sec. 17 and Gov't Lots 1 & 9, Sec. 18, T21N-R13W
Placed 2" iron pipe w/brass cap at perpetuation of record position and is accepted as a careful and faithful perpetuation of the position of the original corner.
S36°W 46.62' 10" W. Oak
S69°W 24.11' 15" B. Oak
N30°E 38.06' 4" B. Oak Clump
N80°E 41.46' 6" W. Oak
N77°W 6.22' End. pipe 3' above ground
South 1.0' Carsonite Witness Post

Signed by

Date

12 JAN 93

Surveyor's Michigan License No.

12018