

LAND CORNER RECORDATION CERTIFICATE  
Filing Requirement of Act 74, Mich. P.A. 1970

1993

COMMISSION

REGISTER'S OFFICE  
MANISTEE COUNTY

#93-287 AT 10 32 A.M.

MAY 12 1993

*Penney A. Pappas*  
REGISTER OF DEEDS

Register of Deeds Stamp & File Number

For corners in

Manistee (County)

Located In:

Corner Code //

1. Public Land Survey

T R

T R

T R

T R

2. Property Controlling  
in Section

S 17 T 24N R 13W

S T R

3. Miscellaneous  
Property in Sec.

S T R

S T R

4. Lot No. , Recorded Plat

5. Private Claims

I, Norman C. Caldwell, in a field survey on September, 19 92

do hereby certify that under requirements of P.A. 74, Michigan P.A. of 1970, the corner points mentioned in lines 1 and 2 above were in conformance with regulations and rules therefore as required in the current manual of survey instructions of the United States Department of the Interior, Bureau of Land Management or by a decree of a Court of Law and/or that the corner points mentioned in lines 3, 4 and 5 above were in conformance with the rules of the Michigan Board of Land Surveyors or by a Decree of a Court of Law; established, re-established, monumented, re-monumented, recovered, found as expressed below:

NOTE: Not more than 4 corners, all in the same town and range, may be recorded on this certificate.

A. Description of original monument and accessories and/or subsequent restoration.

17-1 This position not established by  
original government survey.

17-3.5 Post Placed by J. Brink, 1838  
S35°W 26 lks. (17.2') 6" Maple  
S53°E 34 lks. (22.4') 8" Oak

B. Description of corner evidence found and/or method applied in restoring or reestablishing corner:


17-1 W 1/16 cor. Sec. 8 & 17, T21N-R13W

17-3.5 I.R. @ Inter. Gov't Lots 4 & 5, Sec. 17 and  
Gov't Lots 1 & 9, Sec. 18, T21N-R13W

No subsequent record

County Surveyor's record S.H. Baker, April 1907  
Monument - gas pipe  
N78°W 26.7' 24" W. Pine Stump  
S28°W 47.3' 24" W. Pine Stump

County Surveyor minutes (also in field notes)  
by Theodore Norlin, June 9, 1922  
Set iron pipe  
N79°W 27.5' 30" Pine Stump  
S30°W 47.7' 24" Pine Stump

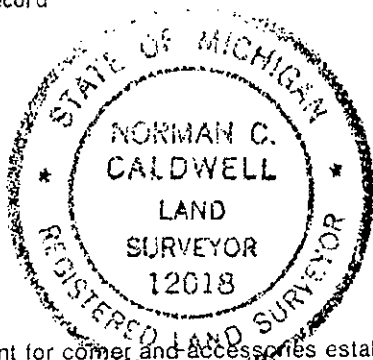

C. Description of monument for corner and accessories established to perpetuate locating the position of the corner:

17-1 W 1/16 cor., Sec. 8 & 17, T21N-R13W

17-3.5 I.R. @ Inter. Gov't Lots 4 & 5, Sec. 17 and  
Gov't Lots 1 & 9, Sec. 18, T21N-R13W

Placed 5/8" iron bar w/alum. cap. This position not established by original government survey. This monument is accepted as a careful and faithful determination of the position of the cor.  
N68°W 148.25' 12" W. Oak  
N38°E 78.39' 8" W. Oak  
S43°E 72.81' 12" W. Oak  
S24°W 59.87' 8" B. Oak  
South 25.00' Carsonite Witness Post

Placed 2" iron pipe w/brass cap at perpetuation of record position and is accepted as a careful and faithful perpetuation of the position of the original corner.  
S36°W 46.62' 10" W. Oak  
S69°W 24.11' 15" B. Oak  
N30°E 38.06' 4" B. Oak Clump  
N80°E 41.46' 6" W. Oak  
N77°W 6.22' End. pipe 3' above ground  
South 1.0' Carsonite Witness Post

Signed by

Date

12 JAN 93

Surveyor's Michigan License No.

12018