

# LAND CORNER RECORDATION CERTIFICATE

FILING REQUIREMENT OF ACT 74, MICH. P.A.1970

FOR CORNERS OF--	LOCATED IN--	CORNER CODE NUMBER
1. PUBLIC LAND SURVEY	21N N. 14W E. T. S., R. W.	F9
2. PROPERTY CONTROLLING IN SECTION	N. S., R. W.	
3. MISCELLANEOUS PROPERTY IN SECTION	N. S., R. W.	
4. LOT NO.	RECORDED PLAT	
5. PRIVATE CLAIMS		

REGISTER'S OFFICE  
MANISTEE COUNTY  
#93-208 AT 11:10 A.M.  
**APR 20 1993**  
*Penney A. Brown*  
REGISTER OF DEEDS

REGISTER OF DEEDS STAMP AND  
FILING NUMBER

I, Patrick R. Leemon do hereby certify that under requirements of P.A. 74, Michigan P.A. of 1970, the corner points mentioned in lines 1 and 2 above (identified with circles on index code diagram—over) were, in a field survey on January 23 1993 established, re-established, monumented, re-monumented, recovered or restored as expressed below and in conformance with regulations and rules therefore as required in the current manual of survey instructions of the United States Department of the Interior, Bureau of Land Management or by a decree of a court of law. Furthermore, that the corner points mentioned in lines 3, 4 and 5 above were, in a field survey on 19, found, recovered, restored, established or re-established as expressed below and in conformance with the rules of the Michigan State Board of Registration for Land Surveyors or, by a Decree of a Court of law:

A. Description of original monument and accessories and/or subsequent restoration:

**1/4 corner common to section 21 and 28 of T21N R14W**

1962 Survey by Robert A. Griffin

Monu. Fd. and used a 6" sq. by 48" long concrete monu.

Witnesses

Maple 12 N25W 8.15'

Cedar 5 S11W 76.35'

W.Pine 20 S68W 84.10'

Cedar Post 3 West 1.5'

B. Description of corner evidence found and/or method applied in restoring or re-establishing corner:

The cedar is now dead and the post has been replaced. In 1978 the Forest Service replaced the 6x48 concrete monument with a 5" sq. by 60" long concrete monument and took the following witnesses. Liber 73 Page 62 documents the history of this corner as perpetuated by Griffin.

Maple 12 N25W 8.25'

Cedar 5 S11W 76.40'

W.Pine 20 S68W 84.13'

Pine Post 4 West 2.32'

C. Description of monument for corner and accessories established to perpetuate locating the position of the corner:

**1/4 corner common to section 21 and 28 of T21N R14W**

Monu. 5" sq. by 60" long concrete monu. with 3" brass disk.

Witnesses

Maple 12 N25W 8.25'

R.Maple 8 S20W 24.53'

W.Pine 20 S68W 84.13'

Pine Post 4 West 2.32'

R.Maple 10 N15E 26.79'

**SURVEY &  
REMONUMENTATION**

**1993**

**COMMISSION**

SIGNED BY Patrick R. Leemon DATE January 25, 1993

SURVEYOR'S MICHIGAN REGISTRATION NO. 31595

FOR STATE AND UNITED STATES AGENCIES:


SIGNED BY \_\_\_\_\_ DATE \_\_\_\_\_

CHIEF OF SURVEY PARTY

APPROVED AND SIGNED BY \_\_\_\_\_ DATE \_\_\_\_\_

MICHIGAN REGISTERED LAND SURVEYOR

SURVEYOR'S MICHIGAN REGISTRATION NO. \_\_\_\_\_

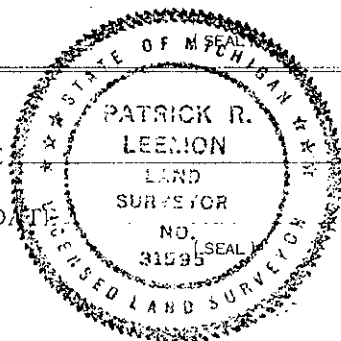

Corner F-2 ratified by the Manistee County Peer Group pursuant to P.A. 123 of 1915, as amended by P.A. 345 of 1990, as amended. Date of Peer Review: FEB 11 1993