

# SURVEY & REMONUMENTATION

APR 03 1996

## COMMISSION LAND CORNER RECORDATION CERTIFICATE

Filing Requirement of Act 74, Mich. P.A. 1970

For corners in

MANISTEE

(County)

Located In:

Corner Code #

1. Public Land Survey

T 21N R 17W

L-1 (MC) ✓

T 22N R 17W

L-13 AC

T R

T R

Other #1

2. Property Controlling in Section

S T R

S T R

3. Miscellaneous

S T R

Property in Sec.

S T R

4. Lot No. , Recorded Plat

5. Private Claims

REGISTER'S OFFICE

MANISTEE COUNTY

#94-286 AT 4:16 p.m.

JUN 23 1994

*Penny G. Papp*  
REGISTER OF DEEDS

Register of Deeds Stamp & File Number

I, Richard L. Hays in a field survey on April 20, 1994, do hereby certify that under requirements of P.A. 74, Michigan P.A. of 1970, the corner points mentioned in lines 1 and 2 above were in conformance with regulations and rules therefore as required in the current manual of survey instructions of the United States Department of the Interior, Bureau of Land Management or by a decree of a Court of Law and/or that the corner points mentioned in lines 3, 4 and 5 above were in conformance with the rules of the Michigan Board of Land Surveyors or by a Decree of a Court of Law; established, re-established, monumented, re-monumented, recovered, found as expressed below:

NOTE: Not more than 4 corners, all in the same town and range, may be recorded on this certificate.

A. Description of original monument and accessories and/or subsequent restoration:

L-1 MEANDER CORNER ON MANISTEE LAKE

1839: G.L.O.

9" W. Oak S-60°-W 43 Lks

14" B. Oak N-87°-W 11 Lks

45.28 Set Post Head Lake

1909: PLAT OF S.C. THOMPSON'S

ADDITION TO THE CITY OF MANISTEE

No Witnesses

1983: ANTHONY SLAWINSKI SURVEY

Fd 2" x 2" Square Iron

Fence Post S-65°-W 3.38'

RR R/W Mon North 0.46'

NW Cor Bldg N-70°-E 12.53'

1989: JENEMA SURVEY

Fd 1" Sq. Iron Rod from

MDOT Witnesses

NW Cor Shed S-34°-W 20.26'

NE Cor Shed N-74°-E 30.64'

12" Ash N-53°-W 47.13'

B. Description of corner evidence found and/or method applied in restoring or reestablishing corner:

L-1 MEANDER CORNER ON MANISTEE LAKE

Found a 1 1/2" Bolt with Nut that fits the witnesses from the Anthony Slawinski Survey and the Jenema Survey. G.L.O. Distance from the Northwest Corner of Section 01 is 2291.52' and measures out to 2242.76'

C. Description of monument for corner and accessories established to perpetuate locating the position of the corner:

L-1 MEANDER CORNER ON MANISTEE LAKE

Replaced 1 1/2" Bolt with Nut with the Standard Manistee County Monument with Brass Cap and is accepted as a careful and faithful re-establishment of the position of the Original Corner.

15" Ash

N-53°-W

47.07'

6" Ash

N-20°-E

38.87'

P. Pole

S-52°-W

32.04'

NW Cor Bldg


N-74°-E

51.22'

Signed by

*Richard L. Hays*

Surveyor's Michigan License No. 25847

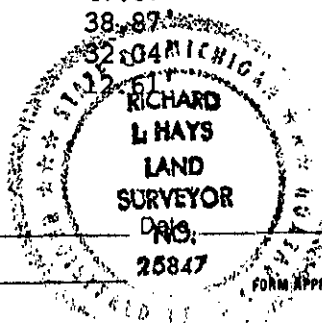

5/3/94

FORM APPROVED BY MICHIGAN STATE BOARD OF LAND SURVEYORS, JAN. 26, 1971  
REVISED MAY 14, 1978  
REVISED JAN., 1989

	A	B	C	D	E	F	G	H	I	J	K	L	M
2	6	5	4	3	2	1							
3													
4	7	8	9	10	11	12							
5													
6	18	17	16	15	14	13							
7													
8	19	20	21	22	23	24							
9													
10	30	29	28	27	26	25							
11													
12	31	32	33	34	35	36							
13													

Reflected by the Manistee County Peer Group  
according to the county plan adopted pursuant to P.A. 345 of 1980,  
as amended, (being the State Survey and Remonument Act, MCL 54.261  
et seq.). Date of Peer Review: JUN 6 1994  
*Richard R. Hays*