

LAND CORNER RECORDATION CERTIFICATE
Filing Requirement of Act 74, Mich. P.A. 1970

1993

COMMISSION

For corners in

Manistee

(County)

Located In:

Corner Code ##

1. Public Land Survey T 22N R 14W C-7
T _____ R _____
T _____ R _____
T _____ R _____
2. Property Controlling S _____ T _____ R _____
in Section S _____ T _____ R _____
3. Miscellaneous S _____ T _____ R _____
Property in Sec. S _____ T _____ R _____

REGISTER'S OFFICE
MANISTEE COUNTY

FEB 2 1993

NO. 93-44 AT 9:22 A.M.
REGISTERED
Register of Deeds Stamp & File Number

4. Lot No. _____, Recorded Plat _____
5. Private Claims _____

	A	B	C	D	E	F	G	H	I	J	K	L	M
2	6		5		4		3		2		1		
3													
4	7		8		9		10		11		12		
5													
6	18		17		16		15		14		13		
7													
8	19		20		21		22		23		24		
9													
10	30		29		28		27		26		25		
11													
12	31		32		33		34		35		36		
13													

I, Robert F. Mitchell in a field survey on September, 19 92, do hereby certify that under requirements of P.A. 74, Michigan P.A. of 1970, the corner points mentioned in lines 1 and 2 above were in conformance with regulations and rules therefore as required in the current manual of survey instructions of the United States Department of the Interior, Bureau of Land Management or by a decree of a Court of Law and/or that the corner points mentioned in lines 3, 4 and 5 above were in conformance with the rules of the Michigan Board of Land Surveyors or by a Decree of a Court of Law; established, re-established, monumented, re-monumented, recovered, found as expressed below:

NOTE: Not more than 4 corners, all in the same town and range, may be recorded on this certificate.

A. Description of original monument and accessories and/or subsequent restoration:

C-7; Northeast Corner Section 19; "Corner in creek, witnessed by 14" elm S87°E, 84L and 10" B. Ash N82°E, 88L," U.S. Survey by Brink, dated 1839. "Found both U.S. witness trees, set witness iron 0.83 chains East on section line from corner." Fargo Survey dated 1909.

B. Description of corner evidence found and/or method applied in restoring or reestablishing corner:


C-7; Northeast Corner Section 19; Found no evidence of U.S. witness trees or Fargo witness iron or witness tree. Fargo monumentation of Government Corners one-half mile in all directions were located. After extensive evaluation of this data, and the creek location, Fargo's original field notes and the actual distances to adjacent corners, this corner was reestablished by double over and on line with the North one-quarter corner of Section 20 and the Northeast Corner of Section 20. This method agrees well with Fargo Survey West, North, and East, and falls in Bear Creek as called for in U. S. Notes. Set 2" by 30" stainless steel pipe with 3" brass cap for witness corners 95.50 feet East of Section Corner on North line Section 20.

C. Description of monument for corner and accessories established to perpetuate locating the position of the corner:

C-7; Witness Corner

2" by 30" Stainless Steel Pipe
95.50' East of Section Corner

N42°W 10" Hemlock 18.50'
S86°E 7" Hemlock 6.92'
N23°E 6" Sugar 10.91'
S63°E 14" Hemlock 26.80'

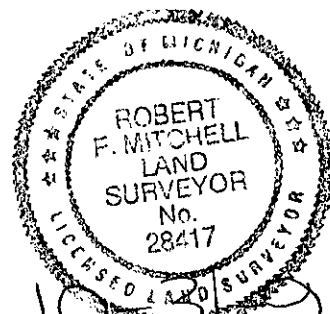

Signed by

Date

Surveyor's Michigan License No. 28417

ratified by the Manistee
County Peer Group pursuant to P.A. 123 of
1915, as amended by P.A. 345 of 1990, as
amended. Date of Peer Review: JAN - 11 1993