

LAND CORNER RECORDATION CERTIFICATE

FILING REQUIREMENT OF ACT 74, MICH. P.A. 1970

| FOR CORNERS OF--: | LOCATED IN--: | CORNER CODE NUMBER |
|---|---|----------------------|
| 1. PUBLIC LAND SURVEY_____ | T. <u>22</u> N. <u>X</u> , R. <u>16</u> W. | <u>B-7; C-7; C-9</u> |
| 2. PROPERTY CONTROLLING IN SECTION_____ | T. _____ N. <u>S</u> , R. _____ E. <u>W</u> . | _____ |
| 3. MISCELLANEOUS PROPERTY IN SECTION_____ | T. _____ N. <u>S</u> , R. _____ E. <u>W</u> . | _____ |
| 4. LOT NO. _____, RECORDED PLAT _____ | | |
| 5. PRIVATE CLAIMS _____ | | |

REGISTER OF DEEDS STAMP AND FILING NUMBER

I, Carl F. Roser do hereby certify that under requirements of P.A. 74, Michigan P.A. of 1970, the corner points mentioned in lines 1 and 2 above (identified with circles on index code diagram—over) were, in a field survey on 3-16 1973, established, re-established, monumented, re-monumented, recovered or restored as expressed below and in conformance with regulations and rules therefore as required in the current manual of survey instructions of the United States Department of the Interior, Bureau of Land Management or by a decree of a court of law. Furthermore, that the corner points mentioned in lines 3, 4 and 5 above were, in a field survey on _____ 19____, found, recovered, restored, established or re-established as expressed below and in conformance with the rules of the Michigan State Board of Registration for Land Surveyors or, by a Decree of a Court of law:

A. Description of original monument and accessories and/or subsequent restoration:

B. Description of corner evidence found and/or method applied in restoring or re-establishing corner:

- B-7 Fd. concrete subn Mon. by RLS Bill Batzer who recovered J. H. Millard corner from surveys of record dated 1900 and 1926.
- C-7 RLS Bill Batzer recovered stk & wit from J. H. Millard survey of record, 1926. Tony Slowinski, RLS, also used Batzer pipe. Ddt conc. mon for Sec cor is N09 03'W, 22.04'.
- C-9 Found 3/4" sq. head bolt, 12'± S of irregular fence to E and 3'± S of irregular fence to W. Accepted as SE corner of Sec. 19.

C. Description of monument for corner and accessories established to perpetuate locating the position of the corner:

| B-7 | C-7 | C-9 |
|----------------------------|---------------------------|--------------------------|
| Found 4" Concrete Monument | Fd 1/2" pipe. Added Cedar | Found 3/4" Sq. Head Bolt |
| 6" W. Pine S 3W 30.30' | post w/loc. tag. | 12" Hemlock N81W 41.35' |
| 6" R. Pine S78E 27.77' | 9" W. Pine S12W 34.30' | P. Pole S41E 50.10' |
| 6" R. Pine N 8W 27.85' | 10" Oak S65W 20.30' | Cor. Fn Post N70E 31.85' |
| | 5" Oak S74E 6.83' | w/loc tag |
| | N-S Rand. Due W 4.0' | Approx ctr N-S |
| | | Gravel Rd Due W 3'± |

SIGNED BY Carl F. Roser DATE 6-15-73SURVEYOR'S MICHIGAN REGISTRATION NO. 12028


FOR STATE AND UNITED STATES AGENCIES:

SIGNED BY _____ DATE _____

CHIEF OF SURVEY PARTY

APPROVED AND SIGNED BY _____ DATE _____

MICHIGAN REGISTERED LAND SURVEYOR

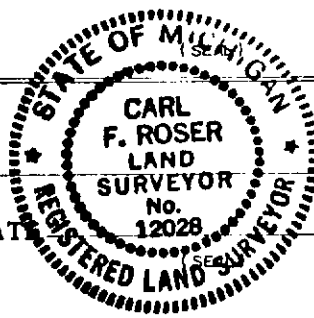

SURVEYOR'S MICHIGAN REGISTRATION NO. _____