


LAND CORNER RECORDATION CERTIFICATE
Filing Requirement of Act 74, Mich. PA 1970

For Corners In:
Manistee
(County)
Located In
Corner Code #
1. Public Land Survey
2. Property Controlling in Section
3. Miscellaneous Property in Section

4. Lot No:
Recorded Plat:
5. Private Claims:

I, Craig W. McVean, in a field survey on Oct. 15, 2009 do hereby state that under requirements of PA 74, Michigan PA of 1970, the corner points mentioned in lines 1 and 2 above were in conformance with regulations and rules therefore as required in the current manual of survey instructions of the United States Department of the Interior, Bureau of Land Management or by a decree of a Court of Law and/or that the corner points mentioned in lines 3, 4 and 5 above were in conformance with the rules of the Michigan Board of Land Surveyors or by a Decree of a Court of Law; established, re-established, monumented, recovered, found as expressed below:

NOTE: Not more than 2 corners, all in the same town and range, may be recorded on this certificate.

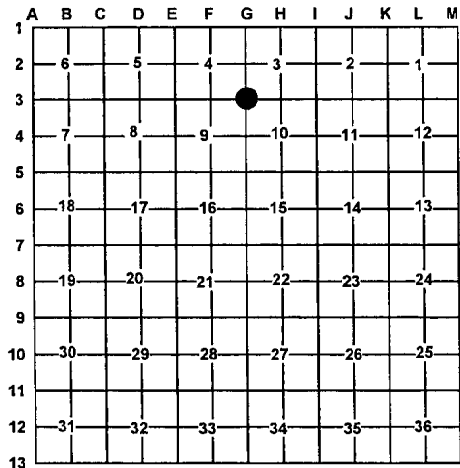

A. Description of original monument and accessories and/or subsequent restoration:

- G3 - 1839 - GLO - Set Post - H. Brevort Jr.
1) Beech 10" N8 1/2° E 21L.; 2) Beech 16" S43°E 28 L.
- 1913 - CSR - L. A., p. 194 & 195 - Fd. Iron - J. H. Millard
3) Cherry 20" SE 35 L.
- 1923 - CSR - L. 13, p. 344 - T. Norlin - iron pipe;
3) Cherry 20" SE 23.10 ft.
- 1968 - Consumer's Power Co. Field notes - Found 1" iron - 6" down
4) S47°E 36" Maple 39.10'; 5) NE Cor. Hse. S54°E 98.64';
6) Power pole N68°E 92.16'; 7) 6" Pine S36°W 70.87'; 3'± S of centerline. E-W gravel rd. 15'± E. of centerline gravel rd. to S. 13'± W. of centerline trail to N.

- 1972 - LCRC #73-9; C. F. Roser. Recovered corner per J. H. Millard. Found 1 1/4" Ir. Pin - buried 0.4';
6) P. Pole Transf. N72°E 92.13';
4) 37" Maple S43°E 39.92'; 7) 7" R. Pine S42°W 70.94';
Approx. Int. Gravel roads S-E-W N72°W 17'±

B. Description of corner evidence found and/or method applied in restoring or re-establishing corner:

- G3 - Section Corner common to Sections 3, 4, 9 & 10 - Found 1 1/2" x 13" long iron pin - down 0.8' - in gravel road. Centerline E-W gravel road is 6'± N. Centerline gravel road S. is 12.5'± West. Witnesses #1, 2, 3 & 5 are gone. Position fits County Surveys by Millard, Muensher and Norlin. 1 1/2" iron pin accepted as the best available evidence of the position of the original corner.

C. Description of monument for corner and accessories established to perpetuate locating the position of the corner:

- G3 - Replaced 1 1/2" x 13" Long iron pin with stamped 3 1/4" Manistee Co. Remon. Brass cap on 2" x 30" long galv. iron pipe.
Place 1 1/2" iron pin in Co. Mon. as memorial.
N70°E 92.07' to set PK and Tag at fd. PK and nail in S. side Power Pole with Transformer (#6)
S40°E 39.63' to fd. 60d nail in SW side 41" S. Maple (#4)
S44°W 70.71' to fd. 60d nail in NW side 16" R. Pine (#7)
S73°W 96.92' to set N & T in N. side 14" R. Pine scribed 'XBT'.
N24°W 86.00' to set N & T in W. side 11" Cherry
S55°W 70' to set Blue Carsonite Post with loc. tag



Signed by: [Signature of Craig W. McVean]
Surveyor's Michigan License No.: 39088

Date: 12/10/2009