

SURVEY & REMONUMENTATION

OCT 3 1 1994

COMMISSION

LAND CORNER RECORDATION CERTIFICATE Filing Requirement of Act 74, Mich. P.A. 1970

For corners in

<u>Manistee</u> (County)	Located In:	Corner Code #
1. Public Land Survey	T <u>23N</u> R <u>15W</u>	C-05
	T _____ R _____	_____
	T _____ R _____	_____
	T _____ R _____	_____
2. Property Controlling in Section	S _____ T _____ R _____	_____
	S _____ T _____ R _____	_____
3. Miscellaneous Property in Sec.	S _____ T _____ R _____	_____
	S _____ T _____ R _____	_____

REGISTER'S OFFICE
MANISTEE COUNTY

#94-319 AT 4:45 p.m.

JUL 11 1994

Penny A. Peters
REGISTER OF DEEDS

Register of Deeds Stamp & File Number

4. Lot No. _____, Recorded Plat _____
5. Private Claims _____

A	B	C	D	E	F	G	H	I	J	K
2	6		5		4		3		2	
3										
4	7		8		9		10		11	
5										
6	13		17		16		15		14	
7										
8	19		20		21		22		23	
9										
10	30		29		28		27		26	
11										
12	31		32		33		34		35	
13										

Anthony M. Slawinski in a field survey on July 1, 19 94
do hereby certify that under requirements of P.A. 74, Michigan P.A. of 1970, the corner points mentioned in lines 1 and 2 above were in conformance with regulations and rules therefore as required in the current manual of survey instructions of the United States Department of the Interior, Bureau of Land Management or by a decree of a Court of Law and/or that the corner points mentioned in lines 3, 4 and 5 above were in conformance with the rules of the Michigan Board of Land Surveyors or by a Decree of a Court of Law; established, re-established, monumented, re-monumented, recovered, found as expressed below:

NOTE: Not more than 4 corners, all in the same town and range, may be recorded on this certificate.

A. Description of original monument and accessories and/or subsequent restoration:

C-05 SE cor sec 7 T23N R17W

1839 James Higbee D.S. G.L.O. 234
Set post cor sec's 7-8-17 & 18

Manistee County Road Commission
1/2" Gal. iron pipe

#1 Sugar 12 N33°E 50 lks (33.00')

#3 Sw 60.34' 24" Maple

#2 Sugar 24 S71°W 31 lks (20.46')

#4 NW 83.58" P.P.

B. Description of corner evidence found and/or method applied in restoring or reestablishing corner:

C-05 SE cor sec 7 T23N R15W

On July 1, 1994 found 1/2" iron pipe, under pipe found 5/8" capped re-rod 18" long
Condition of record witnesses are; #1 thru #4 are gone.

C. Description of monument for corner and accessories established to perpetuate locating the position of the corner:

C-05 SE cor sec 7 T23N R15W


Replaced 1/2" iron pipe with Manistee County Monument placed in a monument box, and is accepted as a careful and faithful reestablishment of the position of the original corner.

S54°W 74.72' 6" Elm

N61°W 87.50' P.P.

N32°E 103.10' 33" Maple

S50°E 56.82" Tele. Pole

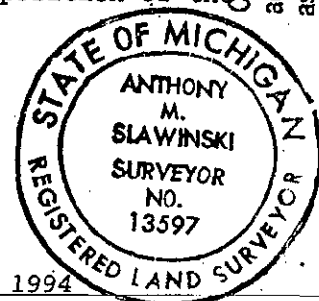

Signed by Anthony M. Slawinski

Date July 1, 1994

Surveyor's Michigan License No. 13597