

DEC 6 1999

LAND CORNER RECORDATION CERTIFICATE
Filing Requirement of Act 74, Mich. P.A. 1970

SECTION

For corners in
Manistee County
(County)

Located In:

Corner Code #

- | | | | | | |
|--------------------------------------|---|------------|---|------------|-------------|
| 1. Public Land Survey | T | <u>24N</u> | R | <u>13W</u> | <u>C-01</u> |
| | T | | R | | |
| | T | | R | | |
| | T | | R | | |
| 2. Property Controlling in Section | S | | T | R | |
| | S | | T | R | |
| 3. Miscellaneous Property in Section | S | | T | R | |
| | S | | T | R | |
4. Lot No. _____, Recorded Plat _____
5. Private Claims _____

REGISTER'S OFFICE
MANISTEE COUNTY

99-298 at 1:20pm
SEP - 9 1999


Deborah Dix
REGISTER OF DEEDS

Register of Deeds Stamp & File Number

I, John C. Schulke, in a field survey on May 19th, 1999

do hereby certify that under requirements of P.A. 74, Michigan P.A. of 1970, the corner points mentioned in lines 1 and 2 above were in conformance with regulations and rules therefore as required in the current manual of survey instructions of the United States Department of the Interior, Bureau of Land Management or by a decree of a Court of Law and/or that the corner points mentioned in lines 3, 4 and 5 above were in conformance with the rules of the Michigan Board of Professional Surveyors or by a Decree of a Court of Law; established, re-established, monumented, re-monumented, recovered, found as expressed below:

NOTE: Not more than 4 corners, all in the same town and range, may be recorded on this certificate.

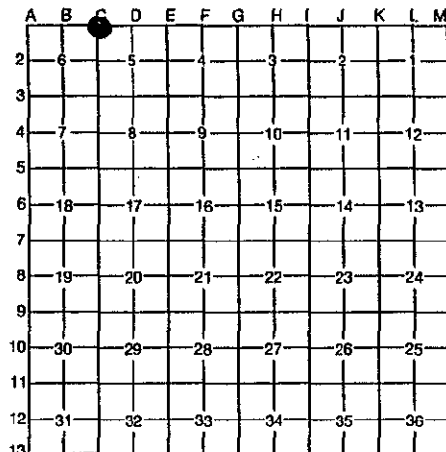

A. Description of original monument and accessories and/or subsequent restoration:

C-01 Closing Corner of Sections 5 and 6, T24N, R13 and Standard Corner of Sections 31 and 32 T25N, R13W.

1838 John Brink US Deputy Surveyor Set Post.

- (1) Hemlock 10" N 27° W 32 links (21.1')
- (2) Hemlock 9" N 33 1/2° E 09 links (5.9')

1839 John Brink on line between Sec 5 and 6 at 83.11 chains intersected North Boundary at post.

- (3) Hemlock 12" S 20° E 17 links (11.2')
- (4) Hemlock 11" S 06° W 13 links (8.6')

1975, LCRC 76-08 G. F. De La Mater LS 13030 found fence corner and remains of old wood stake, replaced with concrete monument.

- (5) Group of 12" Maples S 45° E 37.75 feet
- (6) Group of 10" Maples South 102.80 feet

1981 Survey by Anthony M. Slawinski, RLS 13597, found 4" diameter concrete monument.


- (5) Clump of Maples 12" S 60° E 37.82 feet
- (6) Clump of Maples 16" South 102.78 feet
- (7) Clump of Maples 10" East 51.86 feet

B. Description of corner evidence found and/or method applied in restoring or reestablishing corner:

C-01 Closing Corner of Sections 5 and 6, T24N, R13 and Standard Corner of Sections 31 and 32 T25N, R13W.

Found concrete monument described by De La Mater and BTs 5, 6 and 7. BTs 1, 2, 3 and 4 are gone. Fence is completely down. Abandoned two track which comes from the North, ends at corner.

Corner C-01 ratified by the Manistee County Peer Group according to the county plan adopted pursuant to P.A. 345 of 1990, as amended, (being the State Survey and Remonument Act MCL 54.251 et. seq.). Date of Peer Review: Anthony M. Slawinski
June 6, 1999

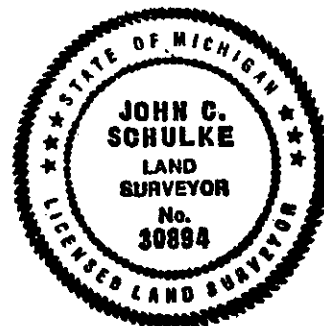

C. Description of monument for corner and accessories established to perpetuate locating the position of the corner:

C-01 Closing Corner of Sections 5 and 6, T24N, R13 and Standard Corner of Sections 31 and 32 T25N, R13W.

Accepted the recovered monument as a suitable marker for C-1 and the best available evidence of the position of the original corner.

References:

- (5) Red Maple Clump 16" S 63° E 37.64 feet (set 60d NE, N trunk)
- (6) Red Maple Clump 16" South 102.78 feet (set 60d W, W trunk)
- (7) Red Maple Clump 16" S 85° E 52.31 feet (set 60d NE, N trunk)
- (8) Red Maple 12" S 06° E 44.20 feet (set 60d W)
- (9) Red Maple 6" N 02° E 30.18 feet (set 60d E)

Signed by

John C. Schulke

Date

July 6th, 1999

Surveyor's Michigan License No.

30894