

LAND CORNER RECORDATION CERTIFICATE
Filing Requirement of Act 74, Mich. P.A. 1970

For corners in

Manistee

(County)

Located In:

Corner Code #

1. Public Land Survey

T24N R16W

M-3

T24N R15W

A-3

2. Property Controlling
in Section

S T R

3. Miscellaneous

S T R

Property in Sec.

S T R

4. Lot No. , Recorded Plat

5. Private Claims

REGISTER'S OFFICE
MANISTEE COUNTY

93-634 at 9:45 A.M.

NOV 3 1993

Penny A. Rogers
REGISTER OF DEEDS

Register of Deeds Stamp & File Number

I, Bruce J. Jenema, in a field survey on Sept. 22, 1993

do hereby certify that under requirements of P.A. 74, Michigan P.A. of 1970, the corner points mentioned in lines 1 and 2 above were in conformance with regulations and rules therefore as required in the current manual of survey instructions of the United States Department of the Interior, Bureau of Land Management or by a decree of a Court of Law and/or that the corner points mentioned in lines 3, 4 and 5 above were in conformance with the rules of the Michigan Board of Land Surveyors or by a Decree of a Court of Law; established, re-established, monumented, re-monumented, recovered, found as expressed below:

NOTE: Not more than 4 corners, all in the same town and range, may be recorded on this certificate.

A. Description of original monument and accessories and/or subsequent restoration:

M-3 Southeast corner of Section 2, originally established by the General Land office survey by John Brink 11-4-1836
Set Post Section 1 & 12 Witness by
Beech 8" N80°W 10 links, Beech 11" S47 1/2°W 18 links
J.H. Mallard 1901 Found Stone at corner of Road, Government corner by
Testimony of L.C. Long Witness by Sugar 16" S55°E 89 links, Book
B, page 56. Also noted page 287, Book A, Found Stone for a survey in
Section 7, T24N, R16W,


B. Description of corner evidence found and/or method applied in restoring or reestablishing corner:

M-3 Found 10" square lime stone buried 3' deep. We located this point by
measurement of 20.01 ch (1320.66') from the N 1/16 corner between
Sections 12 & 7 of T26N, R16W, which is an iron bolt and noted as an
iron bolt, Witness by
10" Beech N87°E 51 1/2 links (Found this witness) and a
10" Beech N58°E 76 links

Corner M-03 ratified by the Manistee
County Peer Group pursuant to P.A. 123 of
1915, as amended by P.A. 345 of 1990, et
amended. Date of Peer Review: APPROVED OCT - 4 1993

C. Description of monument for corner and accessories established to perpetuate locating the position of the corner:

M-3 Southeast corner of Section 1
2"x30" Stainless steel pipe with brass cap
12" below the surface witness by
Electric pole N83°W 50.16'
8" Ash S65°E 91.68'
Electric pole S89°E 167.50'
East NE corner of House S65°W 139.65'
1" Iron bold South 1320.26'

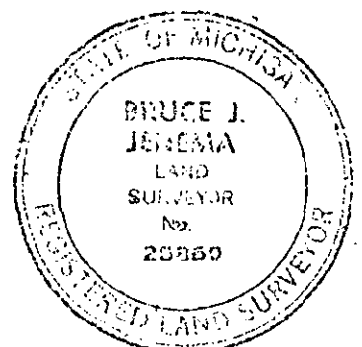

Signed by

Bruce J. Jenema

Date

Sept. 28, 1993

Surveyor's Michigan License No.

25850