

SURVEY &
REMONUMENTATION

SEP 30 1993

COMMISSION

LAND CORNER RECORDATION CERTIFICATE
Filing Requirement of Act 74, Mich. P.A. 1970

For corners in

MASON
(County)

Located In:

Corner Code #

1. Public Land Survey

T 17N R 15W



L-5

2. Property Controlling
in Section


S T R

3. Miscellaneous
Property in Sec.

S T R

4. Lot No. , Recorded Plat

5. Private Claims

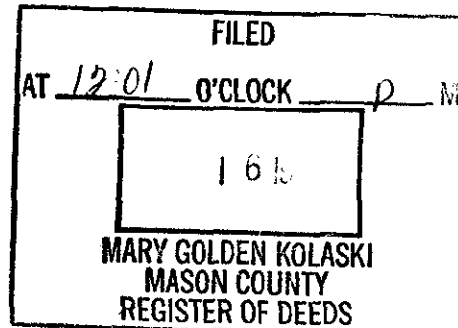

Register of Deeds Stamp & File Number

I, Sammy S. Barnett, in a field survey on AUGUST, 1993,
do hereby certify that under requirements of P.A. 74, Michigan P.A. of 1970, the corner points mentioned
in lines 1 and 2 above were in conformance with regulations and rules therefore as required in the
current manual of survey instructions of the United States Department of the Interior, Bureau of Land
Management or by a decree of a Court of Law and/or that the corner points mentioned in lines 3, 4 and 5
above were in conformance with the rules of the Michigan Board of Land Surveyors or by a Decree of a
Court of Law; established, re-established, monumented, re-monumented, recovered, found as
expressed below.

**NOTE: Not more than 4 corners, all in the same town and range, may be recorded
on this certificate.**

	A	B	C	D	E	F	G	H	I	J	K	L	M
2	6	5	4	3	2	1							
3													
4	7	8	9	10	11	12							
5													
6	18	17	16	15	14	13							
7													
8	19	20	21	22	23	24							
9													
10	30	29	28	27	26	25							
11													
12	31	32	33	34	35	36							
13													

A. Description of original monument and accessories and/or subsequent restoration:

K-5 Section corner, Sec's., 11, 12, 13 & 14

L-5

1/4 corner, Sec's., 12 & 13

Post placed by John Hodgeson in October, 1838

Subdivision survey. S 84° E 211ks. (13.86') 4" Sugar

S 61° W 141ks. (9.24') 12" Elm

R. D. Towns found Iron in March 1902 survey.

No References

Post placed by John Hodgeson in 1838 Subdivision survey

N 66° E 181ks. (11.88') 6" Lynnwood

S 36° W 411ks. (27.06) 6" Beech

B. Description of corner evidence found and/or method applied in restoring or reestablishing corner:

K-5 Section corner, Sec's., 11, 12, 13 & 14

L-5

1/4 corner, Sec's., 12 & 13

Sam Barnett found Spike, during a survey for
John Kistler & Ass. in October, 1972.

S 09° W 19.93' "X" on top, in center
of NW corner of bridge


N 44° W 38.00' Tele. phone pole

R. D. Towns found Stone in March 1902 survey.

Sam Barnett found 1 1/2" Iron Pipe, Set 1/2"
Iron Pipe, in October, 1972 survey.

04° E 33.81' 6" Ash

N 65° E 66.98' Power Pole

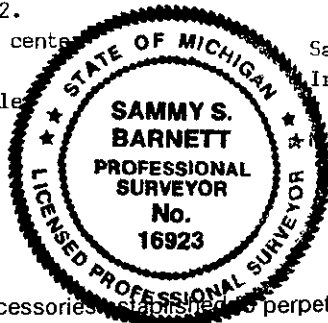

C. Description of monument for corner and accessories established to perpetuate locating the position of the corner:

K-5 Section corner, Sec's., 11, 12, 13 & 14

L-5

1/4 corner, Sec's., 12 & 13

Found 5/8" Iron rod, replaced with 5/8" X 24" re-rod
with 2 1/2" alum. cap, and is accepted as the best
available evidence of the position of the original
corner.

N 63° E 75.35' Power Pole #293

S 48° E 94.25' Power Pole #1451

S 32° W 117.70' NE cor. of Old Schoolhouse

N 40° W 38.22' Fence corner Post

Found 1/2" Iron Pipe set by S. Barnett replaced
with 5/8" re-rod by 24" in length, with 2 1/2"
alum. cap., and is accepted as the best available
evidence of the position of the original corner.

N 74° E 120.53' Power Pole #1292

S 04° E 34.10' 10" Black Ash

N 27° W 122.92' 7" Elm

N 20° W 133.70' 20" White Oak

Signed by Sammy S. Barnett

Date 8/24/93

Surveyor's Michigan License No. 16923

Peer Group Reviewed
and Approved

Date: 9-9-93

Kenneth L. Ross
Mason County Surveyor

FORM APPROVED BY MICHIGAN STATE BOARD OF LAND SURVEYORS, JAN. 28, 1971
REVISED MAY 14, 1975
REVISED JAN., 1983

LIBER

3 PAGE 101