

SURVEY &
REMONUMENTATION

JAN 23 2001

SECTION

LAND CORNER RECORDATION CERTIFICATE

Filing Requirement of Act 74, Mich. P.A. 1970

For corners In: Located In: Corner Code #
Mason County

1. Public Land Survey T 17N R 17W H-9
T R
T R
T R
2. Property Controlling S T R
in Section S T R
3. Miscellaneous S T R
Property in Sec. S T R

4. Lot No. , Recorded Plat
5. Private Claims

I, Kenneth L. Ross in a field survey on September 18, 2000, Do hereby certify that under requirements of P.A. 74, Michigan P.A. of 1970, the corner points mentioned in lines 1 and 2 above were in conformance with regulations and rules therefore as required in the current manual of survey instructions of the United States Department of the Interior, Bureau of Land Management or by a decree of a Court of Law and/or that the corner points mentioned in lines 3, 4 and 5 above were in conformance with the rules of the Michigan Board of Land Surveyors or by a Decree of a Court of Law; established, re-established, monumented, re-monumented, recovered, found as expressed below:

¼ corner common to sections 22 and 27 of T17N, R17W

A. Description of original monument and accessories and/or subsequent restoration:

GLO Hodgson 1838
12" Hemlock for gr. post
No witnesses given.

Stephens RLS 7318, 1968 unrec. survey.
Found 1 ¼" pipe
Tel. pole N72E 167.33' #1
Tel. pole S76W 115.17' #2
Cor. fence post Due South 25.34' #3

Ross RLS 17634 unrecorded survey
Fd. 1 ¼" pipe
No witnesses

Towns 1911 B4 P30
Located this corner by stake and
planted stone. No witnesses given.

Hays 1990 & 1993, unrecorded surveys
No references or witnesses

Stephens RLS 7318, 1953 unrecorded
survey, Existing stone, No witnesses

B. Description of corner evidence found and/or method applied in restoring or reestablishing corner:

I found the bottom portion (12") of a well point 6" below the surface and 4' north of the centerline of an East-West gravel road.

The condition of the accessories is as follows: 1 is in good condition, 2 and 3 are gone.

I found nothing to dispute the location of this corner.

C. Description of monument for corner and accessories established to perpetuate locating the position of the corner:

I replaced the existing well point with a Harrison Monument stamped, Mason County Monument RLS 17634. I accepted this as a careful and faithful reestablishment of the position of the original corner.

Fence row to South
P. pole N78W 200.67' (set 60d spike on S. side) #4
Corner fence post S11W 23.49' (set 60d spike on E side) #5
14" Elm S04W 93.08' (set 60d spike on E. side) #6
P. pole N89E 167.07' (ex. 60d spike on S. side) #1

Signed by Kenneth L. Ross
Surveyor's Michigan License No. 17634


Date 10-09-2000

Approved by Peer Review Group on 10-05-2000
Kenneth L. Ross, County Representative

FILED
AT 4:17 O'CLOCK P. M.
OCT 9 2000
MARGARET KOLASKI ELLIOTT
MASON COUNTY
REGISTER OF DEEDS

Register of Deeds Stamp & File Number

	A	B	C	D	E	F	G	H	I	J	K	L	M
1													
2	6	5	4	3	2	1							
3													
4	7	8	9	10	11	12							
5													
6	18	17	16	15	14	13							
7													
8	19	20	21	22	23	24							
9				X									
10	30	29	28	27	26	25							
11													
12	31	32	33	34	35	36							
13													

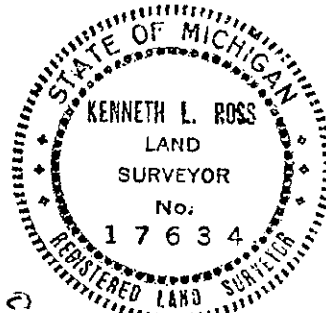

FORM APPROVED BY MICHIGAN STATE BOARD OF LAND SURVEYORS, JAN. 28, 1971
REVISED MAY 14, 1978
REVISED JAN., 1983
ADAPTED FOR WORD PROCESSING MARCH, 1983