

SURVEY & REMONUMENTATION

MAR 16 1998

LIBER -- 4 PAGE 129

SECTION

LAND CORNER RECORDATION CERTIFICATE

Filing Requirement of Act 74, Mich. P.A. 1970

For corners in

MASON

(County)

Located In:

Corner Code #

1. Public Land Survey

T 18 N R 16 W

J - 13

2. Property Controlling
in Section

S

T

R

3. Miscellaneous

S

T

R

Property in Sec.

S

T

R

4. Lot No. _____, Recorded Plat _____

5. Private Claims _____

I, Sammy S. Barnett, in a field survey on Sept. 12 19 97, do hereby certify that under requirements of P.A. 74, Michigan P.A. of 1970, the corner points mentioned in lines 1 and 2 above were in conformance with regulations and rules therefore as required in the current manual of survey instructions of the United States Department of the Interior, Bureau of Land Management or by a decree of a Court of Law and/or that the corner points mentioned in lines 3, 4 and 5 above were in conformance with the rules of the Michigan Board of Land Surveyors or by a Decree of a Court of Law; established, re-established, monumented, re-monumented, recovered, found as expressed below:

NOTE: Not more than 4 corners, all in the same town and range, may be recorded on this certificate.

A. Description of original monument and accessories and/or subsequent restoration:

J - 13 South one-quarter corner, section 35 T18N, R16W

1838 GLO survey by Mullett & Brookfield
Set post

1 Beech 12" N36E 25 lks (16.5')

2 W. Pine 16" N30W 38 lks (25.08')

1886 survey by W. E. Metcalf Dep. Co. Surveyor

Monument not given

3 Pine 16 N30W 38 lks (25.08') still standing (# 2)

1996 survey by S. Barnett found standard con. plat mon.
No witnesses taken

B. Description of corner evidence found and/or method applied in restoring or reestablishing corner:

J - 13 South one-quarter corner, section 35 T18N, R16W

On Sept. 12th 1997 I found the standard con. plat mon. extending 18" out of the ground, condition of the witnesses is as follows.

1 Gone # 2 Gone # 3 Gone (same as # 2)

C. Description of monument for corner and accessories established to perpetuate locating the position of the corner:

J - 13 South one-quarter corner, section 35 T18N, R16W

On Sept 12th 1997, I replaced the con. mon. with a Standard Mason County Monument and accepted this location as a careful and faithful re-establishment of the position of the original corner, and took the following witnesses,

4 White Pine 6" N50W 20.56' 60d spike in SW side

5 Oak 8" N16E 25.39' 60d spike in W side

6 White Pine 6" S20E 16.48' 60 d spike in SW side

7 White Pine 8" S47W 18.55' 60d spike in SE side

8 North one-quarter corner of section 2 T17N R16W is east 1.70'

Remains of old down fence runs north
Gravel road is South 90' + -

Signed by Sammy S. Barnett

Date 11-4-97

Surveyor's Michigan License No. P S # 16923

Peer Group Reviewed

and Approved


Date: Oct 2, 1997

Kenneth L. Ross

Mason County Surveyor

FORM APPROVED BY MICHIGAN STATE BOARD OF LAND SURVEYORS, JAN. 28, 1971
REVISED MAY 14, 1975
REVISED JAN., 1983

LIBER - 4 PAGE 129

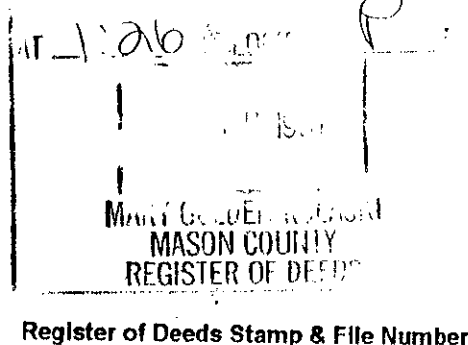

	A	B	C	D	E	F	G	H	I	J	K	L	M
1													
2	6	5	4	3	2	1							
3													
4	7	8	9	10	11	12							
5													
6	18	17	16	15	14	13							
7													
8	19	20	21	22	23	24							
9													
10	30	29	28	27	26	25							
11													
12	31	32	33	34	35	36							
13													

