

# SURVEY & REMONUMENTATION

MAY 07 1997

COMMISSION

## LAND CORNER RECORDATION CERTIFICATE

Filing Requirement of Act 74, Mich. P.A. 1970


For corners in

Mason

(County)

Located in:

Corner Code #

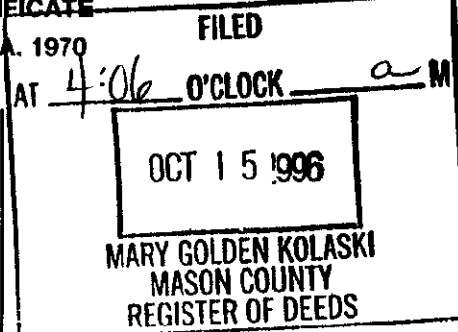

Register of Deeds Stamp & File Number

- |                                      |       |       |     |
|--------------------------------------|-------|-------|-----|
| 1. Public Land Survey                | T 19N | R 18W | I 7 |
|                                      | T     | R     |     |
|                                      | T     | R     |     |
|                                      | T     | R     |     |
| 2. Property Controlling in Section   | S     | T     | R   |
|                                      | S     | T     | R   |
| 3. Miscellaneous Property in Section | S     | T     | R   |
|                                      | S     | T     | R   |

4. Lot No. \_\_\_\_\_, Recorded Plat \_\_\_\_\_
5. Private Claims \_\_\_\_\_

I, Richard Hays, in a field survey on September, 19 96, do hereby certify that under requirements of P.A. 74, Michigan P.A. of 1970, the corner points mentioned in lines 1 and 2 above were in conformance with regulations and rules therefore as required in the current manual of survey instructions of the United States Department of the Interior, Bureau of Land Management or by a decree of a Court of Law and/or that the corner points mentioned in lines 3, 4 and 5 above were in conformance with the rules of the Michigan Board of Professional Surveyors or by a Decree of a Court of Law; established, re-established, monumented, re-monumented, recovered, found as expressed below:

**NOTE:** Not more than 4 corners, all in the same town and range, may be recorded on this certificate.

A. Description of original monument and accessories and/or subsequent restoration:

### I-7 SECTION CORNER COMMON TO SECTIONS 14, 15, 22 & 23

1838:G.L.O. Sibley Survey	1918:C.E. Mitchell	1971:Mason Co. Road Commission	1974:Nordlund #16345, Liber 1, Pg 241	Set 1" Iron Bar
14" Hemlock N-57°-E 32 Lks(1)	Book 2, Page 231	10" Tw. Oak S-60°-E 41.72'(3)	12" Oak N-20°-E 74.25'(7)	
14" Hemlock N-82°-W 22 Lks(2)	NO WITNESSES	15" Oak N-40°-E 90.32'(4)	8" Oak N-30°-E 31.89'(8)	
		10" Tw. Oak N-30°-W 73.19'(5)	St. Sign N-40°-W 51.62'(9)	
1901:Robert O. Towns	1929:Plat of Hamlin	8" W. Pine S-60°-W 57.09'(6)		
Book 4, Page 46	Estates #1			
14" Hemlock N-57°-E 32 Lks(1)	24" Pine Stump N-49°-W 32.00'			
14" Hemlock N-82°-W 22 Lks(2)	24" Pine Stump S-34°-? 99.00'			

B. Description of corner evidence found and/or method applied in restoring or reestablishing corner:

### I-7 SECTION CORNER COMMON TO SECTIONS 14, 15, 22 & 23

1995:Found 1" Iron Bar. The condition of the Recorded Witnesses are as follows:

14" Hemlock N-57°-E 32 Lks(1)	GONE
14" Hemlock N-82°-W 22 Lks(2)	GONE
10" Tw. Oak S-60°-E 41.72'(3)	GONE
15" Oak N-40°-E 90.32'(4)	GOOD
10" Tw. Oak N-30°-W 73.19'(5)	GOOD
8" W. Pine S-60°-W 57.09'(6)	GONE
12" Oak N-20°-E 74.25'(7)	GONE
8" Oak N-30°-E 31.89'(8)	GONE
St. Sign N-40°-W 51.62'(9)	GONE

C. Description of monument for corner and accessories established to perpetuate locating the position of the corner:

### I-7 SECTION CORNER COMMON TO SECTIONS 14, 15, 22 & 23

1996:Replace Found 1" Iron Bar with Standard Mason County Monument with cap stamped to identify Corner in Monument Box, and is accepted as a careful and faithful re-establishment of position of the Original Corner.

15" Tw. W. Oak	N-31°-W	73.19'(5)
23" B. Oak	N-44°-E	90.32'(4)
11" B. Oak	S-83°-E	52.13'
16" Tw. B. Oak	S-61°-W	47.76'

Signed by Richard Hays

Date Sept 22, 1996

Surveyor's Michigan License No. 25847

FORM APPROVED BY MICHIGAN STATE BOARD OF PROFESSIONAL SURVEYORS, JAN. 20, 1994, REVISED JAN. 1996

Peer Group Reviewed

Date:

9-30-96

Kenneth L. Ross

Mason County Surveyor

LIBER

4 PAGE

97

