

APR 28 1995

COMMISSION

LAND CORNER RECORDATION CERTIFICATE  
Filing Requirement of Act 74, Mich. P.A. 1970

For corners in


MASON  
(County)

Located In:

Corner Code #

1. Public Land Survey T 19 N R 15 W J-9  
T R  
T R  
T R
2. Property Controlling S T R  
in Section S T R
3. Miscellaneous S T R  
Property in Sec. S T R

4. Lot No. , Recorded Plat
5. Private Claims

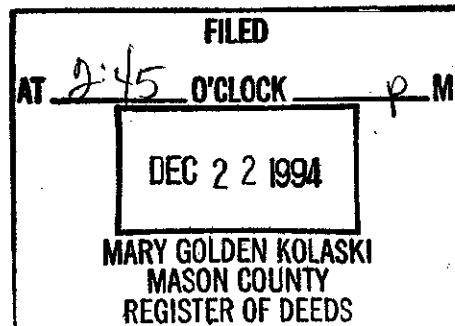

Register of Deeds Stamp & File Number

I, Sammy S. Barnett, in a field survey on December 6, 19 94, do hereby certify that under requirements of P.A. 74, Michigan P.A. of 1970, the corner points mentioned in lines 1 and 2 above were in conformance with regulations and rules therefore as required in the current manual of survey instructions of the United States Department of the Interior, Bureau of Land Management or by a decree of a Court of Law and/or that the corner points mentioned in lines 3, 4 and 5 above were in conformance with the rules of the Michigan Board of Land Surveyors or by a Decree of a Court of Law; established, re-established, monumented, re-monumented, recovered, found as expressed below:

**NOTE: Not more than 4 corners, all in the same town and range, may be recorded on this certificate.**

A. Description of original monument and accessories and/or subsequent restoration:  
J-9 1/4 Corner for Sections 23 & 26, T19N, R15W.

1838, G.L.O. Sylvester Sibley

Set Wood Post

#1 W. Oak 14" S 33° W 361k (23.76')  
#2 Y. Pine 16" N 41° E 171k (11.22')

#3 R. Oak 10" N 66° E 171k (11.22')

#4 W. Oak 9" N 13°- 30; W 271k (17.82')

Book 2, Pages 190 & 191 of County Surveyors Records

1914, C.E. Mitchell, M.C.S.

Set Wood Post by single proportional method

B. Description of corner evidence found and/or method applied in restoring or reestablishing corner:  
J-9 1/4 Corner for Sections 23 & 26, T19N, R15W.

Due to the lack of any confirmed G.L.O. witnesses or other evidence and the lack of any old fences, the position of this corner was determined by locating and using the south end of the Historic West 1/16 line fence and then calculating an inverse between this location and the NW Corner of Section 26. I then calculated an inverse between the NW Corner and the NE Corner in Section 26, (5260.34 feet). I then calculated the Mid-point between NW Corner and the NE Corner of Section 26, (2630.17 feet) to determine the Easting position. I projected a line from the NW Corner of Section 26 through the West 1/16 fence corner, (Grid Bearing N 86°-56'-28" W) to intersect a line due South of this Mid-point to determine the Northing position of this 1/4 corner.

This position was presented to the Mason County Surveyors Peer Review Committee for discussion, and it was agreed that due to the lack of any confirmed evidence to the location of the original 1/4 corner, that holding to old occupation lines was best in this case. Condition of recorded witnesses is; #1 Gone #2 Gone #3 Gone #4 Gone Note; There is a previously file Act 74, on this Corner, file by Jack C. Schulke R.L.S. # 30894, see Liber 3, Page 91, Mason County Corner Records. Corner bears N 06°-56'-36" E a distance of 67.81 feet, from above position.

C. Description of monument for corner and accessories established to perpetuate locating the position of the corner:

J-9 Set a 5/8" x 24" Re-Rod with an aluminum cap stamp Mason county Monument, 2 1/2" in dia. And is accepted as the best available evidence of the position of the original corner.

R. Maple 7" N 51° E 36.41'  
B. Oak 6" S 10° E 18.68'  
R. Oak 6" N 84° W 18.05'  
R. Oak 6" S 72° E 27.03'

Signed by Sammy S. Barnett

Date 12-6-94

Surveyor's Michigan License No. 16923

Peer Group Reviewed,  
and Approved

Date: Dec 5, 1994  
Kenneth L. Ross  
Mason County Surveyor



FORM APPROVED BY MICHIGAN STATE BOARD OF LAND SURVEYORS, JAN. 28, 1971  
REVISED MAY 14, 1975  
REVISED JAN., 1983

LIBER

3 PAGE 249