

**SURVEY & REMONUMENTATION**

OCT 29 1996

COMMISSION

**LAND CORNER RECORDATION CERTIFICATE**

Filing Requirement of Act 74, Mich. P.A. 1970

For corners in Mason Located In: \_\_\_\_\_ Corner Code # \_\_\_\_\_  
 (County)


1. Public Land Survey T 19N R 16W I-06  
 T \_\_\_\_\_ R \_\_\_\_\_  
 T \_\_\_\_\_ R \_\_\_\_\_  
 T \_\_\_\_\_ R \_\_\_\_\_

2. Property Controlling S \_\_\_\_\_ T \_\_\_\_\_ R \_\_\_\_\_  
 In Section S \_\_\_\_\_ T \_\_\_\_\_ R \_\_\_\_\_

3. Miscellaneous S \_\_\_\_\_ T \_\_\_\_\_ R \_\_\_\_\_  
 Property in Sec. S \_\_\_\_\_ T \_\_\_\_\_ R \_\_\_\_\_

4. Lot No. \_\_\_\_\_ Recorded Plat \_\_\_\_\_

5. Private Claims \_\_\_\_\_

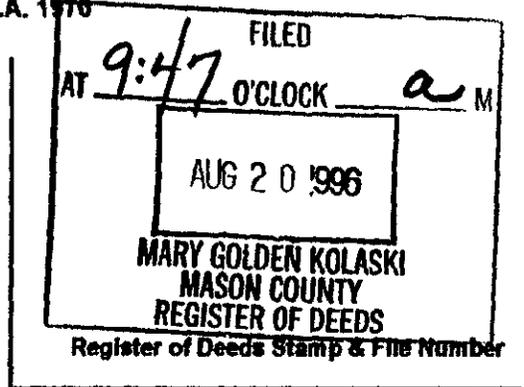

I, Kenneth L. Ross, in a field survey on August 6, 1996, do hereby certify that under requirements of P.A. 74, Michigan P.A. of 1970, the corner points mentioned in lines 1 and 2 above were in conformance with regulations and rules therefore as required in the current manual of survey instructions of the United States Department of the Interior, Bureau of Land Management or by a decree of a Court of Law and/or that the corner points mentioned in lines 3, 4 and 5 above were in conformance with the rules of the Michigan Board of Land Surveyors or by a Decree of a Court of Law; established, re-established, monumented, re-monumented, recovered, found as expressed below:

**NOTE: Not more than 4 corners, all in the same town and range, may be recorded on this certificate.**

**A. Description of original monument and accessories and/or subsequent restoration:**

- I-6 Sec. Cor., 14 & 15-19-16  
 1638 Sylvester Sibley  
 (1) 14" Hemlock N 17 W 9 lks  
 (2) 10" Hemlock S 77 E 4 lks

	A	B	C	D	E	F	G	H	I	J	K	L	M
1													
2	6	5	4	3	2	1							
3													
4	7	8	9	10	11	12							
5													
6	18	17	16	15	X 14	13							
7													
8	19	20	21	22	23	24							
9													
10	30	29	28	27	26	25							
11													
12	31	32	33	34	35	36							
13													

**B. Description of corner evidence found and/or method applied in restoring or reestablishing corner:**


- I-6 Sec. Cor., 14 & 15-19-16  
 May., 1902, R. O. Towns Fd. Stone & Iron (Book 2, Page 31-32, County Surveyor's Records)  
 May., 1902, R. O. Towns Fd. Stone & Iron (Book 4, Page 78-79, County Surveyor's Records)  
 Aug., 1903, R. O. Towns Fd. Stone (Book 2, Page 179-180, County Surveyor's Records)  
 Sep., 1903, R. O. Towns Fd. Stone (Book 4, Page 104-105, County Surveyor's Records)  
 Sep., 1963, K. Stephens Fd. Well Point  
 Jun., 1996, K. Ross Fd. 1 1/2" Pipe, 6' East of CL N-S Road, 10' North of CL Road to East  
 (3) Tel. Box West 37.05'  
 (4) Rd. Name Sign S 30 E 54.65'  
 (5) 6" Cherry N 41 E 75.60'  
 (6) SE G. Rail Post N 06 E 241.46'  
 Aug., 1996, K. Ross Fd. Well Point

**C. Description of monument for corner and accessories established to perpetuate locating the position of the corner:**

- I-6 1/4 Cor., 14 & 15-19-16  
 Fd. Witness # 3, 4, 5, & 6 in good condition.  
 Witness #1 & 2 gone.  
 Replaced Well Point with 5/8" x 36" re-bar with 2 1/2" alum. cap, and is accepted as the best available evidence of the original corner.  
 (7) SW Guard Rail Post N 01 W 241.64'  
 (8) CL Phone Box S 45 W 50.86'  
 (9) Cor. Common Sec. 14, 15, 22, & 23 South 2680.44'

Signed by Kenneth L. Ross Date 8-12-96

Surveyor's Michigan License No. 17634

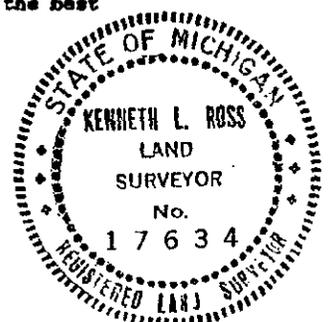

Peer Group Reviewed and Approved  
 Date: 8-13-96  
Kenneth L. Ross