

MAR 16 1998 AND CORNER RECORDATION CERTIFICATE

FILING REQUIREMENT OF ACT 74, MICH. P.A.1970

SECTION

FOR CORNERS OF--

LOCATED IN--

CORNER CODE NUMBER

1. PUBLIC LAND SURVEY T. 20N N. 15W E. S., R. W.
2. PROPERTY CONTROLLING IN SECTION T. N. S., R. E. W.
3. MISCELLANEOUS PROPERTY IN SECTION T. N. S., R. E. W.

E1

Seg. 2

4. LOT NO. , RECORDED PLAT

5. PRIVATE CLAIMS

FILED

AT 10:10 O'CLOCK a

NOV 17 1994

MARY GOLDEN KOLASKI
MASON COUNTY
REGISTER OF DEEDS

REGISTER OF DEEDS STAMP AND
FILING NUMBER

I, Patrick R. Leemon do hereby certify that under requirements of P.A. 74, Michigan P.A. of 1970, the corner points mentioned in lines 1 and 2 above (identified with circles on index code diagram--over) were, in a field survey on October 30 1994, established, re-established, monumented, re-monumented, recovered or restored as expressed below and in conformance with regulations and rules therefore as required in the current manual of survey instructions of the United States Department of the Interior, Bureau of Land Management or by a decree of a court of law. Furthermore, that the corner points mentioned in lines 3, 4 and 5 above were, in a field survey on 19 , found, recovered, restored, established or re-established as expressed below and in conformance with the rules of the Michigan State Board of Registration for Land Surveyors or, by a Decree of a Court of law:

A. Description of original monument and accessories and/or subsequent restoration:

Section corner common to sections 4 and 5 of T20N R15W

1838 survey by Mullett & Brookfield
Set Wood Post
#1 W.Oak S25W 30 links
#2 W.Oak 10 S45E 26 links

1936 search by Carl Kintz USFS
Fd. conc. monu. by Mitchell
No witnesses were taken

1971 survey by Robert A. Griffin 13684
Found the conc. monu. by Mitchell and
set a 5" sq. by 60" long conc. monu.
w/ a 3" brass disk.

1918 survey by C.E. Mitchell
Set Conc. Monu. w/ 1" gas pipe
#3 Pine 16 S18 1/2 W 54 links
#4 Pine 14 S57E 38 links

1985 survey by A.Slawinski #13597
Fd. Griffin monu.
#5 Oak 14 N70E 12.78 feet
#6 Pine 8 S10E 35.64 feet
#7 Maple 7 S65W 51.42 feet
#8 Pine 22 S10W 52.95 feet

#8 R.Pine 17 S10W 52.95 feet
#9 W.Pine 3 S71W 62.83 feet

B. Description of corner evidence found and/or method applied in restoring or re-establishing corner:

I found the 5" square by 60" long concrete monument w/ brass cap by Griffin extending 18" above the surface and 650 feet North of the centerline of the E-W road. Witnesses 1 through 4 are gone. Witness 5 through 9 are in good condition. I could not find a recorded corner certificate by Griffin even though I'm certain one was filed. This monument has been used by Richard Hays #25847 and Clint Cole #17615. I could find no conflicting information that would lead to another location. I therefore accept this monument as a careful and faithful reestablishment of the position of the original corner.


C. Description of monument for corner and accessories established to perpetuate locating the position of the corner:

Section corner common to sections 4 and 5 of T20N R15W

Monu. The 5" square by 60" long concrete monu. with 3" brass disk was left in place

Witnesses:

Rebar 5/8" x 24" N22W 95.32 feet
SW 34 T21N R15W 5x60 conc. monu. West 115.90 feet
B.Oak 14 N76E 12.78 feet (#5)
R.Pine 9 S10E 35.64 feet (#6)
R.Maple 7 S65W 51.39 feet (#7)
R.Pine 19 S10W 52.71 feet (#8)

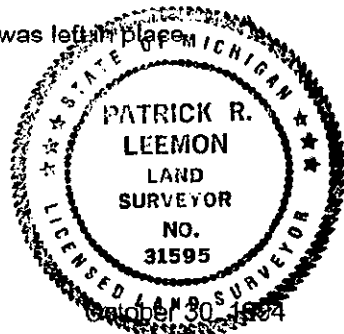

SIGNED BY Patrick R. Leemon 31595

DATE

SURVEYOR'S MICHIGAN REGISTRATION NO.

(SEAL)

FOR STATE AND UNITED STATES AGENCIES:

SIGNED BY CHIEF OF SURVEY PARTY

DATE

APPROVED AND SIGNED BY MICHIGAN REGISTERED LAND SURVEYOR

DATE

(SEAL)

LIBER

3PAGE 202

SURVEYOR'S MICHIGAN REGISTRATION NO.