

MECOSTA COUNTY REMONUMENTATION PROGRAM

Corner approved by Peer Group on March 24, 1994

LAND CORNER RECORDATION CERTIFICATE

Filing Requirement of Act 74, Mich. P.A. 1970

STATE OF MICHIGAN
COUNTY OF MECOSTA
RECEIVED FOR RECORD

For corners in

Mecosta

(County)

Located In:

Corner Code #

'94 AUG -3 P1:38

1. Public Land Survey Sec. T 14 N R 10 W C-1, Mecosta Twp
T R
T R
T R
2. Property Controlling S T R
in Section S T R
3. Miscellaneous S T R
Property in Sec. S T R

Carl Waldron
REGISTER OF DEEDS

Register of Deeds Stamp & File Number

4. Lot No. , Recorded Plat
5. Private Claims

I, Thomas H. Sage a field survey on April 2, 1994,
do hereby certify that under requirements of P.A. 74, Michigan P.A. of 1970, the corner points mentioned
in lines 1 and 2 above were in conformance with regulations and rules therefore as required in the
current manual of survey instructions of the United States Department of the Interior, Bureau of Land
Management or by a decree of a Court of Law and/or that the corner points mentioned in lines 3, 4 and 5
above were in conformance with the rules of the Michigan Board of Land Surveyors or by a Decree of a
Court of Law; established, re-established, monumented, re-monumented, recovered, found as
expressed below:

NOTE: Not more than 4 corners, all in the same town and range, may be recorded
on this certificate.

A. Description of original monument and accessories and/or subsequent restoration:
March 5, 1838, Abner VanNess, Deputy Surveyor, GLO Notes, Volume 2, Page 256
Intersected North boundary 20 links West of Post and set Post common to Sections 5 & 6
Beech 12" S45°W 45 links
Beech 8" S16°E 37 links

June 20, 1901, Lyman W. June, County Surveyor, Field Book #4, Pages 114 and 116, Record Book 1, Page 39
Standard Corner, 2 Bearing Tree stumps -- Stone Corner

1965, George Blass, Witness notes for Southeast Corner, Section 31, T15N-R10W.
Southeast Corner is 13.20 feet East.

1976+/-, Ferris State College -- Student Project

Found 3/4" Pipe
Poplar 8" N38°W 74.80 feet
Oak 18" N52°E 57.92 feet
Power Pole S44°E 89.20 feet

December 15, 1978, Thomas H. Sage, Witness Notes

Found 3/4" Pipe
Poplar 8" N40°W 74.80 feet
Power Pole S45°E 89.20 feet
Oak 18" N50°E 57.92 feet

Railroad Spike East 13.80 Feet, Southwest Corner, Section 32, T15N-R10W

April 18, 1990, Duane Wood, LCRC, Liber 2, Page 318

Found 1/2" Pipe
W. Oak 24" N60°E 57.97 feet
Power Pole S36°E 89.23 feet
W. Oak 8" S40°W 75.78 feet
W. Pipe 12" N25°W 80.10 feet

Continued on back

B. Description of corner evidence found and/or method applied in restoring or reestablishing corner:
Found 1/2" Rebar in Intersection of 12 Mile Road and 230th Avenue, 10" +/- deep on April 2, 1994. The 1/2" Rebar was bent 0.3 +/-
West (top was 14.06 feet West of USFS Monument for Southwest Corner, Section 32, T15N-R10W). I removed the 1/2" Rebar
and set a remonumentation monument using FSC's and my 1978 witness information for control. NOTE: My June 3, 1993
witnesses do not fit the position of the remonumentation monument.

C. Description of monument for corner and accessories established to perpetuate locating the position of the corner:

Remonumentation Monument

Oak 24"	N52°E 57.65'	Nail in Westside with USFS Tag
Power Pole	S44°E 89.20'	Nail in Westside
Pine 12"	N45°W 79.74'	Nail in Westside
White Oak 12"	S45°W 75.76'	Nail in Southside with USFS Tag
USFS Post	N45°E 60.24'	USFS Tag and Nail
USFS Monument East	13.80'	


This monument is accepted as a careful and faithful perpetuation of the position of the original corner.

Signed by Thomas H. Sage Date MAY 10, 1994

Surveyor's Michigan License No. 33139

APPROVED BY MECOSTA CO. PEER GROUP
IN ACCORDANCE WITH P.A. 345 of 1990

James B. Knapp
CHAIRMAN
DATE MAR. 24, 1994

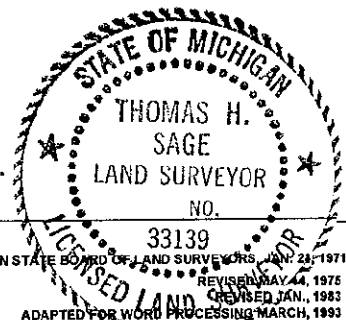

FORM APPROVED BY MICHIGAN STATE BOARD OF LAND SURVEYORS, JAN. 28, 1971
REVISED MAY 44, 1976
REVISED JAN., 1983
ADAPTED FOR WORD PROCESSING MARCH, 1993

1102
-101
E-101
A. Continued

May 31, 1993, Thomas H. Sage, Witness Notes

June 3, 1993, Thomas H. Sage, Recorded Survey, Liber 11, Page 667 and 668

Found 1/2" Rebar

Pole S35°E 89.15 feet, Nail in Westside

Oak 24" N60°E 57.90 feet, USFS Tag with Nail

USFS Post, N45°E 50.55 feet, USFS Tag with Nail

Pine 12" N45°W 79.80 feet, nail in Westside

Oak 12" S 45°W 75.50 feet, Nail in Southside