

REMO

NOV 18 1997

COMMISSION

## MECOSTA COUNTY REMONUMENTATION PROGRAM

CORNER APPROVED BY PEER GROUP ON SEPTEMBER 12, 1997

## LAND CORNER RECORDATION CERTIFICATE

Filing Requirement of Act 74, Mich. P.A. 1970

STATE OF MICHIGAN  
COUNTY OF MECOSTA  
RECEIVED FOR RECORD

For corners in

Mecosta

(County)

Located in:

Mecosta Twp

Corner Code #

'97 NOV -7 P2:24

1. Public Land Survey SEC 34 T14N R10W H-13  
     T R  
     T R  
     T R  
 2. Property Controlling S T R  
     in Section S T R  
 3. Miscellaneous S T R  
     Property in Sec. S T R

*James Brown*  
 REGISTER OF DEEDS

Register of Deeds Stamp &amp; File Number

4. Lot No. \_\_\_\_\_, Recorded Plat \_\_\_\_\_  
 5. Private Claims \_\_\_\_\_

I, James J. Keller, in a field survey on August 11 19 97, do hereby certify that under requirements of P.A. 74, Michigan P.A. of 1970, the corner points mentioned in lines 1 and 2 above were in conformance with regulations and rules therefore as required in the current manual of survey instructions of the United States Department of the Interior, Bureau of Land Management or by a decree of a Court of Law and/or that the corner points mentioned in lines 3, 4 and 5 above were in conformance with the rules of the Michigan Board of Land Surveyors or by a Decree of a Court of Law; established, re-established, monumented, re-monumented, recovered, found as expressed below.

NOTE: Not more than 4 corners, all in the same town and range, may be recorded on this certificate.

## A. Description of original monument and accessories and/or subsequent restoration:

June 29, 1837, John Hodgson, Deputy Surveyor G.L.O. "Set Quarter Section Post"  
 16" Beech N24°E 22 Links (14.52') 7" Lynn N75°W 22 Links (14.52')  
 at 40.25 chains (2656.5' or 16.5' W of Quarter Post) stream 10 Links (6.6') Southwest

June 3, 1920, C.E. Freeman, County Surveyor (Corner not found)

Circa 1930, Mecosta County Road Commission "Stones in Mound" (No witnesses Given)

November 3, 1975, Douglas W. Hooth R.L.S. #7966 M.S.H.D. (L.C.R.C. Liber 1, Page 249) "Found Nest of Stones 18" below surface and on old fence line to the North; placed 1 1/4" Iron 30" Long"  
 6" Willow N40°W 25.02' 4" Elm N45°E 26.12' 16" Hemlock (face) S75°E 50.26'

August 30, 1989, William G. Tingley R.L.S. #30104, (Unrecorded Survey #89247) N. 1/4 Corner Section 3, T13N, R10W N89°38'28"E 207.41'

## B. Description of corner evidence found and/or method applied in restoring or reestablishing corner:

August 11, 1997, James J. Keller R.L.S. #10693 "Found 1 1/4" Steel Shaft 3" deep in Line Old Fence Remains to the North"  
 Set 60d N.E. side 12" Willow N40°W 25.0'  
 Set 60d S.E. side 10" Dead Elm N45°E 26.1'  
 Face 16" Hemlock S75°E 50.2'

APPROVED BY MECOSTA CO. PEER GROUP  
 IN ACCORDANCE WITH P.A. 345 of 1990

*James J. Keller*  
 CHAIRMAN  
 DATE Sept. 12, 1997


## C. Description of monument for corner and accessories established to perpetuate locating the position of the corner:

Accepted 1 1/4" Steel Shaft as best evidence of the position of the Original Corner and Set Remonumentation Monument over it.

Found M.S.H.D. Tag and Set 60d and Tag above 12" Willow N40°W 24.95'  
 Found 60d and Set Tag S.E. side 10" Dead Elm N45°E 26.10'  
 Face 16" Hemlock S74°E 50.20'  
 Set 60d and Tag W. side 4" Maple S02°W 7.50'  
 Set 60d and Tag E. side 5" Cherry N05°W 10.88'  
 Edge of Road Shoulder South 9.0'  
 Edge of Road Shoulder North 16.0'


Signed by James J. Keller  
 Surveyor's Michigan License No. 10693

Date September 12, 1997

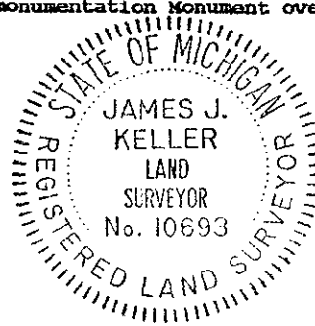

11.50 file

LJH  
September 5, 1997

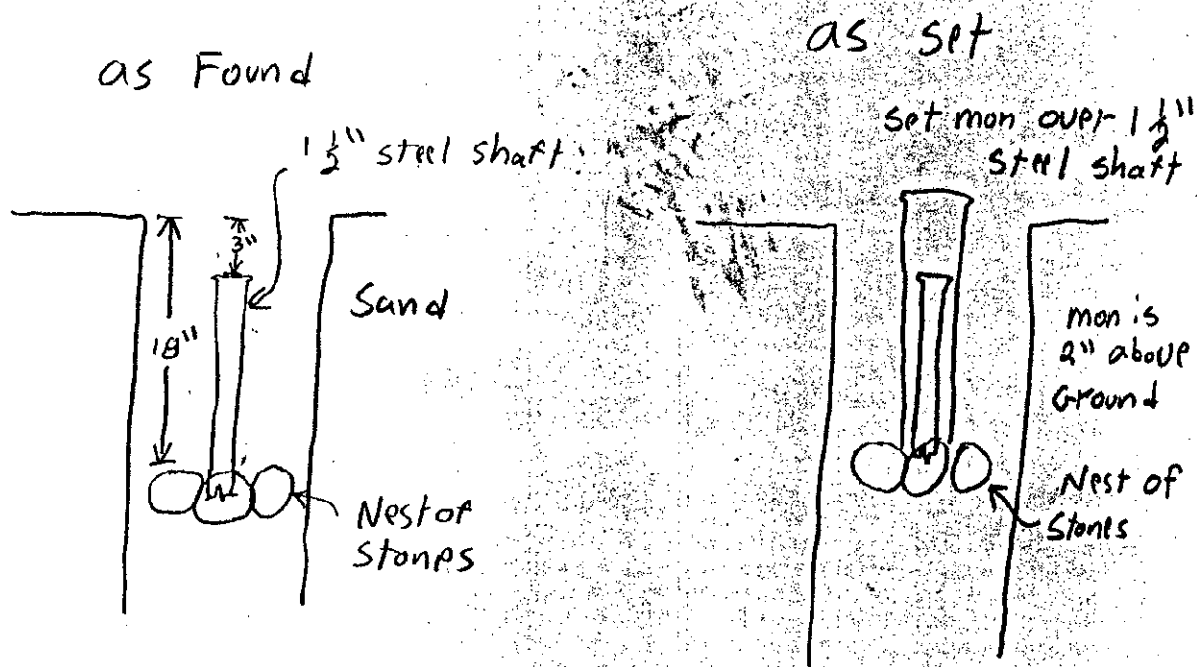

SURVEY &  
REMONUMENTATION

NOV 18 1997  
COMMISSION