

SURVEY &
REMONUMENTATION

MECOSTA COUNTY REMONUMENTATION PROGRAM

MAY 05 1997 CORNER APPROVED BY PEER GROUP ON December 13, 1996

COMMISSION

LAND CORNER RECORDATION CERTIFICATE

Filing Requirement of Act 74, Mich. P.A. 1970

STATE OF MICHIGAN
COUNTY OF MECOSTA
RECEIVED FOR RECORD

For corners in

Mecosta
(County)

Located In:

Mecosta Twp.

Corner Code #

'96 DEC 17 AM 1:31

1. Public Land Survey SEC 2 T14N R10W K-1
T R
T R
T R
2. Property Controlling S T R
in Section S T R
3. Miscellaneous S T R
Property in Sec. S T R

Joanne Brown
REGISTER OF DEEDS

Register of Deeds Stamp & File Number

4. Lot No. _____, Recorded Plat _____
5. Private Claims _____

I, James J. Keller, in a field survey on Sept-Oct 19 96, do hereby certify that under requirements of P.A. 74, Michigan P.A. of 1970, the corner points mentioned in lines 1 and 2 above were in conformance with regulations and rules therefore as required in the current manual of survey instructions of the United States Department of the Interior, Bureau of Land Management or by a decree of a Court of Law and/or that the corner points mentioned in lines 3, 4 and 5 above were in conformance with the rules of the Michigan Board of Land Surveyors or by a Decree of a Court of Law, established, re-established, monumented, re-monumented, recovered, found as expressed below:

NOTE: Not more than 4 corners, all in the same town and range, may be recorded on this certificate.

A. Description of original monument and accessories and/or subsequent restoration:

November 30, 1837, Abner E. VanNess, Deputy Surveyor G.L.O. "81.00 Intersected Boundary Line 21 Links (13.86 feet) East of Post & Set Post Cor. to Sect. 1 & 2"
18" Pine 851°E 10 Links = 6.6 feet 24" Pine S16°W 10 Links = 6.6 feet
September 6, 1972, Patrick A. Salisbury RLS #13594 (Survey L. 10, P. 108-109)
"Found Iron" (No witnesses given)
June 13, 1973, Gerald J. Gray, RLS #17741 (Survey L. 10, P. 180) "N.E. Sec. Corner"
Nail P. Pole N35°W 63.4' Nail 20" Buckeye N25°W 73.3' Street Sign S42°W 41.0'
(Circa 1975) Ferris Students "Fnd. Mon." 13.8' East of S.E. Corner Section 35-15-10
P.P. N05°E 45.48' 20" Buckeye N14°E 68.97' P.P. N36°W 72.81'
December 2, 1976, Gerald J. Gray, RLS #17741 (Survey L. 10, P. 404-405) "Fnd Monument"
N10°E 45.5 Power Pole N19°E 69.0' 20" Buckeye N40°W 72.5' Power Pole
June 27, 1978, Gerald J. Gray, RLS #17741 (Survey L. 10, P. 592-595) "Found Monument"
N10°E 45.5 Power Pole N19°E 69.0' 20" Buckeye N40°W 72.5' Power Pole
September 27, 1978, Gerald J. Gray, RLS #17741 (LCRC L. 1, P. 465) "Found Monument"
N10°E 45.5 Power Pole N19°E 69.0' 20" Buckeye N40°W 72.5' Power Pole
August 14, 1979, Gerald J. Gray, RLS #17741 (LCRC L. 1, P. 513) "Found Monument"
N10°E 45.5 Power Pole N19°E 69.0' 20" Buckeye N40°W 72.5' Power Pole
September 30, 1986, Duane F. Wood, RLS #24625 (LCRC L. 2, P. 139) "Found Concrete Monument"
N10°E 45.5 Power Pole N19°E 69.0' 20" Buckeye N40°W 72.5' Power Pole
May 6, 1985, Duane F. Wood, RLS #24625 (Survey L. 11, P. 161-162)
"N.E. Corner", "Found Conc. Monument"
P. Pole N35°W 63.40' 20" Buckeye N25°E 73.30' Sign Post S42°W 41.00'

appears to be for SE corner Sec 34-15-10

B. Description of corner evidence found and/or method applied in restoring or reestablishing corner:

November 27, 1996 J.J. Keller RLS # 10693 Found 4" Concrete Monument 48" long 15" deep
20" Buckeye N18°E 68.87'
Remon monument West 13.78'
Guy pole N10°E 46.40'
Found 4" concrete monument S41°E 46.82'

appears to be for SE Corner SEC 34-15-10


APPROVED BY MECOSTA CO. PEER GROUP IN ACCORDANCE WITH P.A. 343 of 199

James J. Keller
CHAIRMAN
DATE DEC 13, 1996

C. Description of monument for corner and accessories established to perpetuate locating the position of the corner:

Accepted concrete monument as best evidence of the original location of the corner and replaced with remonumentation monument in box.

Set PK & tag NE side Distribution pole N43°W 72.81'
Set PK & tag SE side Guy pole N19°E 46.40'
Set 60d & tag NW side 5" Black Oak N33°E 43.45'
Found 4" concrete monument S41°E 46.82'
Set 60d & tag N side 10" Black Oak S52°E 33.18'
(K-13) SE corner (Remonumentation monument Sec 35-15-10) West 13.78'
Set 60d & tag in 20" Dead Buckeye N18°E 68.87'

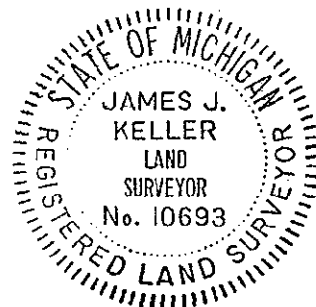

Signed by James J. Keller Date December 13, 1996


Surveyor's Michigan License No 10693

FORM APPROVED BY MICHIGAN STATE BOARD OF LAND SURVEYORS, JAN. 28, 19
REVISED MAY 14, 11
REVISED JAN. 11
ADAPTED FOR WORD PROCESSING MARCH, 11

11-27-1996

LJH JJK

as Found

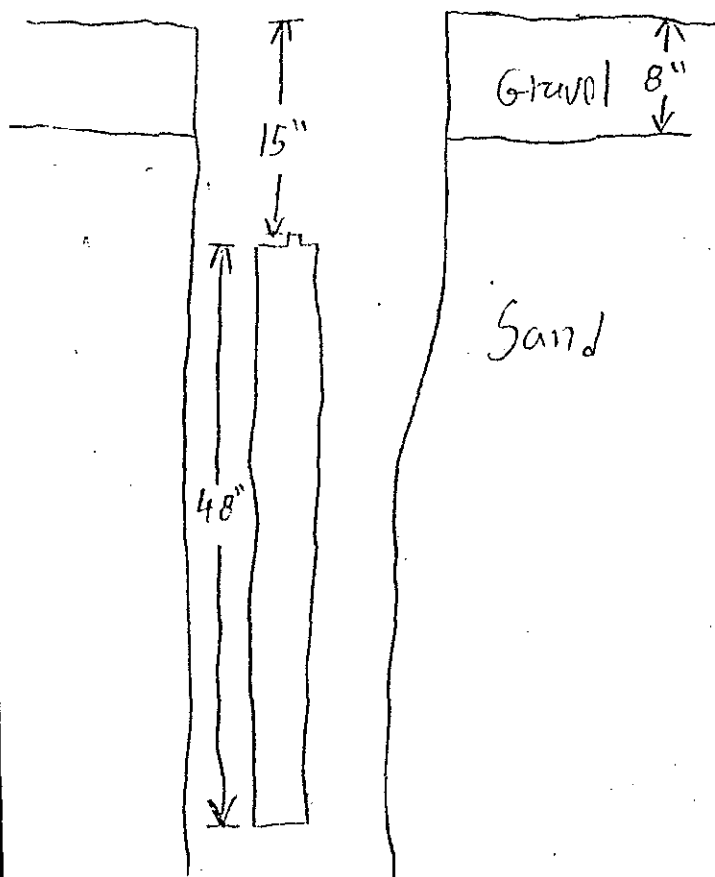

as Set

